IREDELL COUNTY HEALTH DEPARTMENT

STATESVILLE 704-878-5305 MOORESVILLE 704-664-5281

IMPROVEMENT PERMIT / AUTHORIZATION TO CONSTRUCT / OPERATION PERMIT / EXISTING SYSTEM INSPECTION

PERMIT# 151308 PIN# 4719885637 DATE 7-21-08

OWNER OR APPLICANT Samuel G. Scott Contracting Co, Inc. PHONE: Business 704 902-3230 Home

ADDRESS Vance Farm Rd

LOCATION 115 North, Left Bowles Farm Rd, 1st rd on (L) on Vance Farm

SUBDIVISION Seven Oaks @ Cools Farm BLOCK / SECTION LOT 16 LOT AREA 1.1996 SITE CLASS. PS DESIGN FLOW 360 L.T.A.R. .3

Septic Tank: 1000 Gallons; STB 1012 Date 2-7-08

Pump Tank: Gallons; PT Date

Pump Make: Model Serial No.

Nitrification Field: No Fields 1 Square Feet 1200 Linear Feet 300

No Lines 3 Trench Width 36" Max Trench Bottom Depth 36"

☒ New System ☐ Repair ☐ Expansion System Type: I II III IV V VI

System Description: 25% Reduction Gravity

Repair System Description: 25% Reduction Gravity

Maintenance Agreement Required: ☐ Yes ☒ No

☒ House/Mod. Home ☐ Mobile Home ☐ Business ☐ Other No. Bedrooms 3 No. Persons No. Employees


Water Supply: ☒ Individual ☐ Public ☐ Community

Gravel Depth ☒ Gravity ☐ Pressure ☐ Slab ☒ Crawl Space ☐ Basement w/plumbing ☐ Basement wo/plumbing

Comments:/Conditions:


272

INITIAL SITE SKETCH

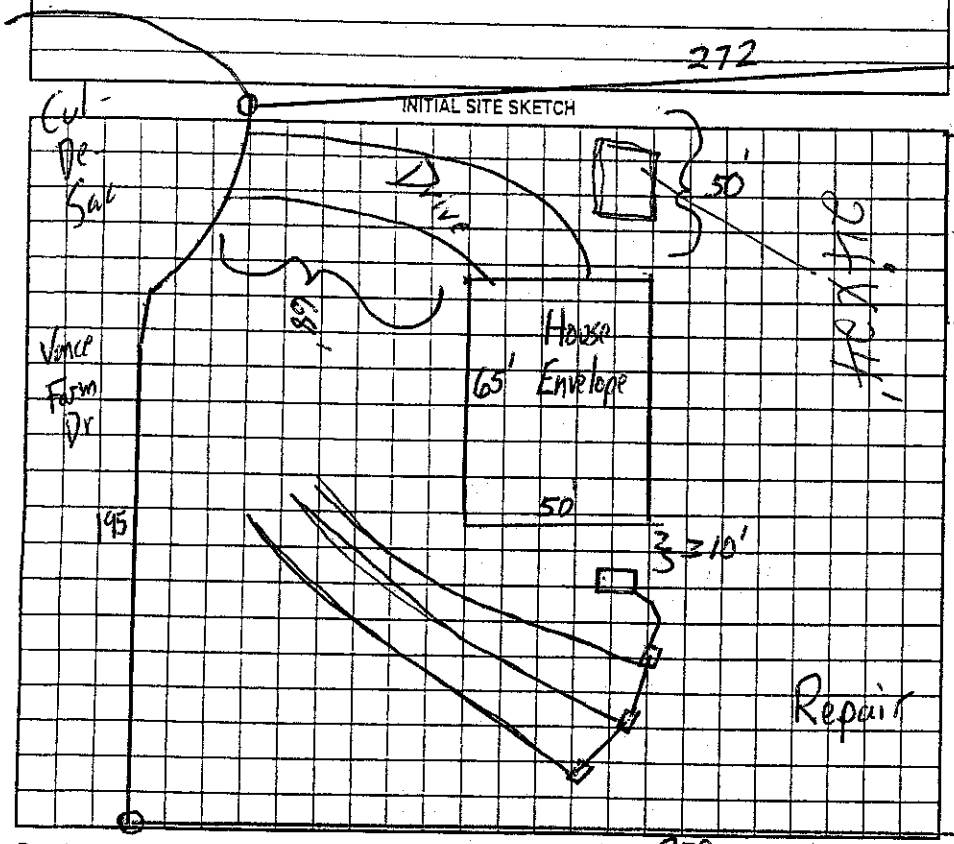

Comments:/Conditions:

AS BUILT SKETCH

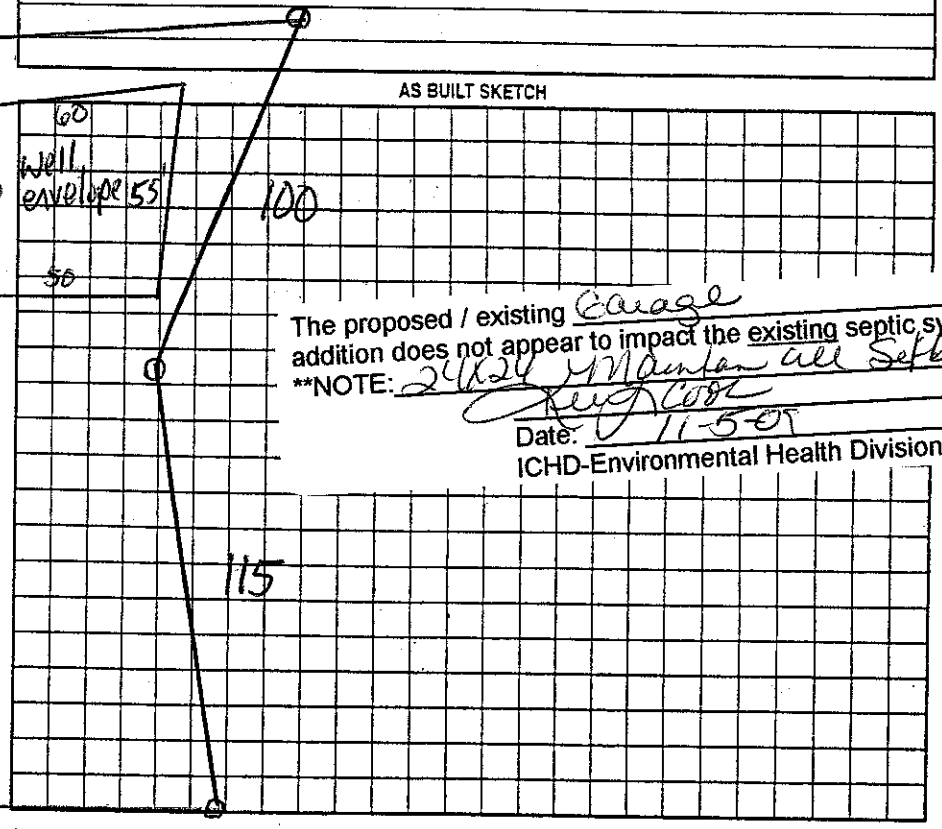

The proposed / existing Garage addition does not appear to impact the existing septic system.

**NOTE: 24x24 Maintain all Setbacks R.S.

Date: 1-5-09

ICHD-Environmental Health Division

Permit can be suspended or revoked if any false information is supplied toward securing the permit/any unauthorized changes are made to the site/any unauthorized changes are made in the installation of the system. Improvement Permit with plat valid without expiration ☐ Improvement Permit with site plan valid for sixty months ☒ Authorization to Construct is valid for a period equal to that of Improvement Permit – not to exceed sixty months.

Signed: date 1-22-08 Installed by: Young Grading

Improvement Permit by: date 7-21-08 Operation Permit by: date 1-30-09

Authorization to Construct by: date 7-21-08 Existing System Inspection by: date

HEALTH DEPT. COPY: WHITE OWNER COPY (FINAL): YELLOW OWNER COPY (INITIAL): PINK