IREDELL COUNTY HEALTH DEPARTMENT

STATESVILLE 704-878-5305 MOORESVILLE 704-664-5281

IMPROVEMENT PERMIT / AUTHORIZATION TO CONSTRUCT / OPERATION PERMIT / EXISTING SYSTEM INSPECTION

PERMIT# 118680 PIN# 4719-90-2675 DATE 3-11-04

OWNER OR CONTRACTOR JERRY HILL PHONE: Business Home 704-876-1930

ADDRESS 248 HILL DAIRY RD STATESVILLE 28625

LOCATION 115 N (L) HILL DAIRY RD FIRST MOBILE HOME PAST DAIRY ON (L) (0.8 MILE)

SUBDIVISION BLOCK / SECTION LOT LOT AREA 103.0 SITE CLASS. PS DESIGN FLOW 240 L.T.A.R. .25 GPD/FT²

Septic Tank: 1000 Gallons; STB 1007 Date 5-11-04
Pump Tank: Gallons; PT Date
Pump Make: Model Serial No.
Nitrification Field: No Fields 1 Square Feet 960 Linear Feet 320
No Lines 4 Trench Width 36" Max Trench Bottom Depth 24" Gravel Depth 12"

☑ New System ☐ Repair System Type: I, (II), III, IV, V, VI
System Description: CONVENTIONAL GRAVITY
Repair System Description: LOW-PRESSURE
Maintenance Agreement Required: ☐ Yes ☑ No

☐ House/Mod. Home No. Bedrooms 2
☑ Mobile Home No. Bathrooms 2
☐ Business No. Employees
☐ Other
☐ Slab ☑ Crawl Space ☐ Basement w/plumbing ☐ Basement wo/plumbing


Water Supply: ☑ Individual ☐ Public ☐ Community WELL

Comments:/Conditions: (1) MAINTAIN SETBACKS (2) INSTALL LINES 24" ON CONTOUR (3) MUST RE-ROUTE POWER AND WATER LINES AROUND SEPTIC SYSTEM (4) WATER LINES SHALL BE MINIMUM 10' FROM SYSTEM.

Comments:/Conditions: SEPTIC TANK WITH RISER & MARKER INSTALLED USING "PolyLok" RED FILTER

SCALE 1"= 50'

INITIAL SITE SKETCH

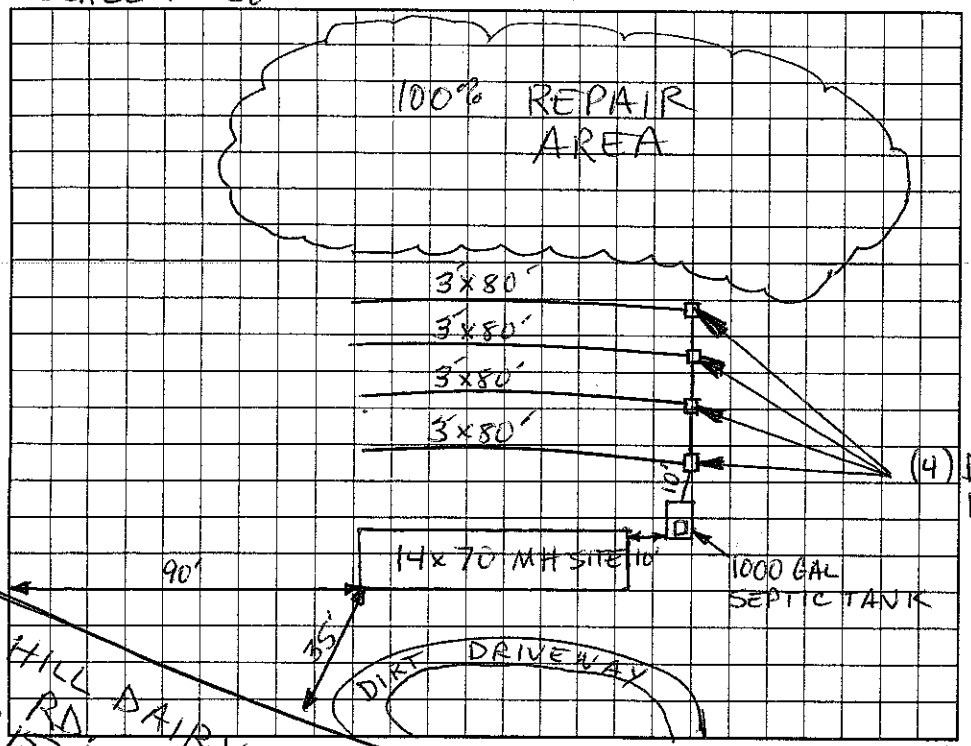

AS BUILT SKETCH

SYSTEM INSTALLED 32" DEEP (EIGHT INCHES DEEPER THAN PERMITTED) EIGHT EXTRA INCHES OF STONE INSTALLED FOR A TOTAL OF 20" GRAVEL DEPTH — AS SHOWN

Permit can be suspended or revoked if any false information is supplied toward securing the permit/any unauthorized changes are made to the site/any unauthorized changes are made in the installation of the system. Improvement Permit with plat valid without expiration. Improvement Permit with site plan valid for sixty months. Authorization to Construct is valid for a period equal to that of Improvement Permit – not to exceed sixty months.

Signed: Jerry Hill date 3-11-04

Improvement Permit by: Christopher M. Sheill, RS date 3-11-04

Authorization to Construct by: Christopher M. Sheill, RS date 3-11-04

Installed by: JAMES HUDLER

Operation Permit by: STEVE HENDRICK date 7-2-04

Existing System Inspection by: date

HEALTH DEPT. COPY: WHITE OWNER COPY (FINAL): YELLOW OWNER COPY (INITIAL): PINK