IREDELL COUNTY HEALTH DEPARTMENT

Statesville Phone TR 3-7271 Mooresville Phone NC 3-1271

PERMIT TO INSTALL SEPTIC TANK

Permit No. 213 Permit Date April 1 1971

Owner Jerry Hill Address Rt. 11 - Statesville, NC

Installed By Lackey Bros. Address Stony Point, N.C.


Location of Property North on Highway #115 - Cross Snow Creek - Turn Left on Road # 1572 - 5th House on Right.

Tank		Capacity		Length of Lines		Fixtures	
Block	( )	1000	(✓)	225'	(✓)	No of Baths	(2)
Precast	(✓)	1250	( )	250'	( )	Dishwasher	( )
		1500	( )	Other		Garbage Grdr.	( )
		Other				Other	

NOTIFY HEALTH DEPARTMENT AT LEAST EIGHT HOURS BEFORE TANK IS TO BE INSPECTED.

Final Inspection April 1 1971 Approved (✓) Disapproved ( )

Remarks WATER SUPPLY From Fathers Farm

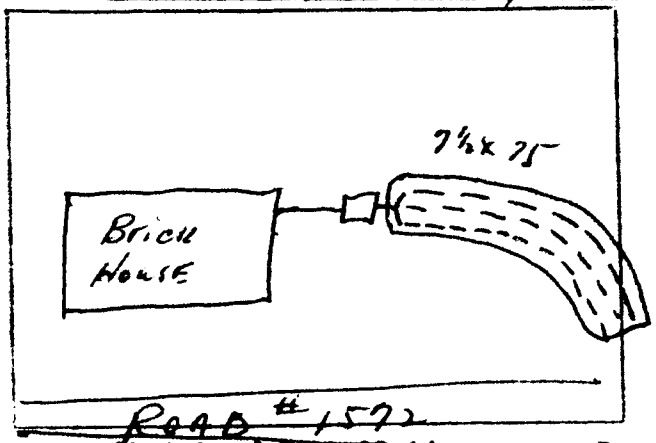

Sketch of Installation

Sanitarian