# IREDELL COUNTY HEALTH DEPARTMENT

STATESVILLE 704-878-5305 MOORESVILLE 704-664-5281

## IMPROVEMENT PERMIT / CERTIFICATE OF COMPLETION / OPERATION PERMIT / EXISTING SYSTEM INSPECTION

PROPERTY DESCRIPTION NO. _____ DATE 11-4-97 TAX MAP NO. _____

OWNER OR CONTRACTOR Iredell Statesville Schools PHONE: Business 872-6931 Home _____ Watershed: ☐ Yes ☐ No

ADDRESS PO Box 911

LOCATION 115 N TL before central school on Hill Dairy Rd 1/8 mi Rt

SUBDIVISION _____ BLOCK / SECTION _____ LOT _____ LOT AREA approx 1/2 acre SITE CLASS. 105 DESIGN FLOW 400 GPD T.A.R. .35

Septic Tank: 1000 Gallons; STB 1012 Date 9-5-97

Pump Tank: _____ Gallons; PT _____ Date _____

Pump Make: _____ Model _____ Serial No. _____

Nitrification Field: No Fields 1 Square Feet 918 Linear Feet 306

No Lines 4 Trench Width 36" Max Trench Bottom Depth 36" Gravel Depth _____

☐ New System ☐ Repair System Type: I, II, III, IV, V, VI

System Description: _____

Repair System Description: Gravity Chambers

Maintenance Agreement Required: ☐ Yes ☐ No

☐ House/Mod. Home No. Bedrooms ___

☐ Mobile Home No. Bathrooms ___

☐ Business No. Employees ___

☑ Other after School Day Care Bldg. 40 students 2 hrs/day

☐ Slab ☐ Crawl Space ☐ Basement w/plumbing ☐ Basement wo/plumbing


Water Supply: ☐ Individual ☑ Community ☐ Public

Comments:


018 S.T. was crushed by Gravel Truck
Repair by Replacement System as Shown

Comments:

**INITIAL SITE SKETCH**

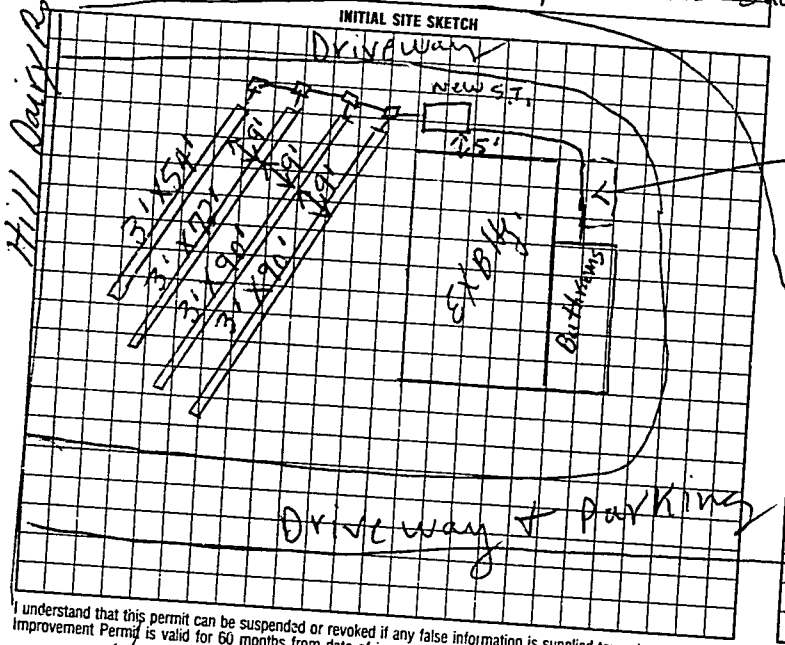


**AS BUILT SKETCH**

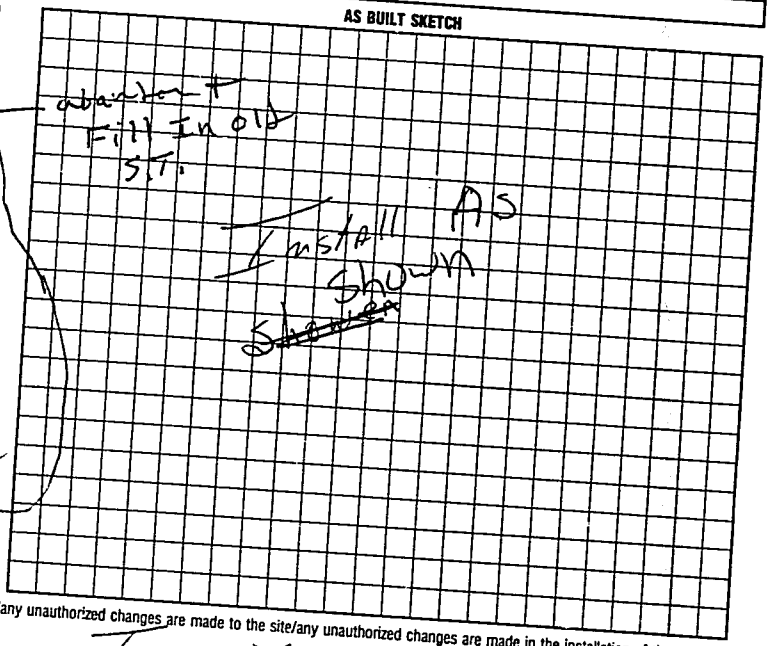


I understand that this permit can be suspended or revoked if any false information is supplied toward securing the permit/any unauthorized changes are made to the site/any unauthorized changes are made in the installation of the system. Improvement Permit is valid for 60 months from date of issuance.

Signed: X Harold R. Beam

Improvement Permit by: E.C. Moore date 11-4-97

Existing System Inspection by: E.C. Moore date 11-4-97

Authorization to Const.

Installed by: Tommy Frye

Certificate of Completion by: _____

Operation Permit by: _____ date 12-12-97

HEALTH DEPT. COPY: WHITE INSPECTION COPY (FINAL): GREEN OWNER COPY (FINAL): YELLOW INSPECTION COPY (INITIAL): PINK OWNER COPY (INITIAL): GOLD date 12-12-97

Authorization to Const EXPIRES 60 mos from issue