IREDELL COUNTY HEALTH DEPARTMENT

STATESVILLE 704-878-5305 — MOORESVILLE 704-664-5281

IMPROVEMENT PERMIT / AUTHORIZATION TO CONSTRUCT / OPERATION PERMIT / EXISTING SYSTEM INSPECTION

PERMIT # Repair PIN # 4719 98 7975 DATE 5-2-12

OWNER or APPLICANT Dale Robinson PHONE: Business 704-928-9527 Home: 704-876-6942

OWNER or APPLICANT ADDRESS 4096 Wilkesboro Hwy

LOCATION / DIRECTIONS North on Hwy 115N - directly across from Central Elementary

SUBDIVISION n/a BLOCK / SECTION n/a LOT # n/a LOT AREA 1.27 Ac. DESIGN FLOW 360 L.T.A.R. .25

Septic Tank 1000 Gallons: STB 760 Date 9-25-12
Pump Tank ____ Gallons: P T ____ Date ____
Pump Make ____ Model ____ Serial # ____
Nitrification Field No Fields 1 No Lines 05 Linear Feet ~~360~~ 360
Trench Width 36" Max. Trench Bottom Depth 36" Gravel Depth n/a

☐ New System ☒ Repair ☐ Expansion System Type I II (III) V V VI
System Description: ____
Repair System Description: 25% Reduction
Maintenance Agreement Required ☐ YES ☒ NO
☒ GRAVITY ☐ PRESSURE


☒ Residence No. Bedrooms 3
☐ Business No. Persons ____
☐ Other No. Employees ____
☐ Slab ☐ Crawl Space
☒ Basement w/plumbing ☐ Basement w/o plumbing

Water Supply: ☒ Private ☐ Public ☐ Community


Comments / Conditions: Keep new tank > 50' from wells

Comments / Conditions:

INITIAL SITE SKETCH

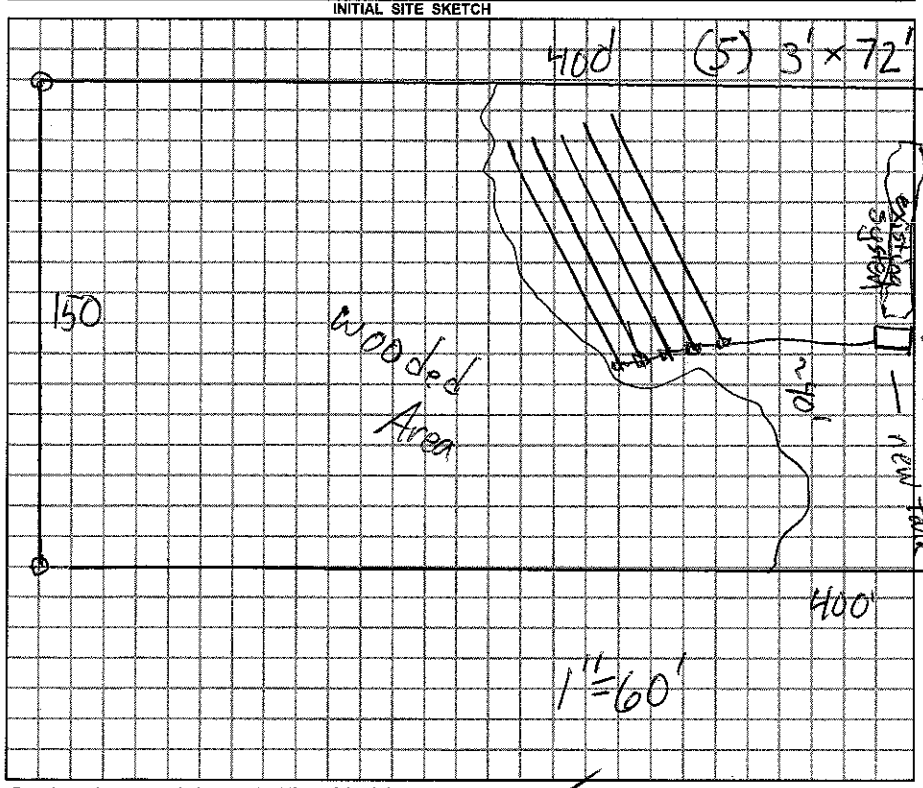

AS BUILT SKETCH

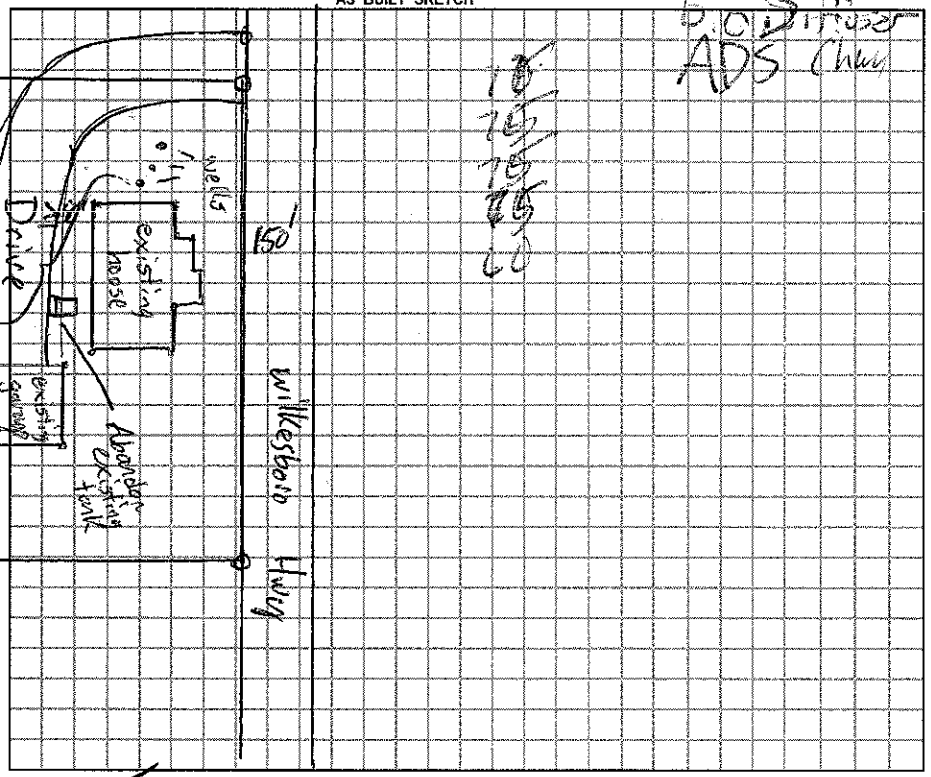

Permit can be suspended or revoked if any false information is supplied toward securing the permit / any unauthorized changes are made to the site / any unauthorized changes are made in the installation of the system.

☐ *IMPROVEMENT PERMIT w / plat valid without expiration.* ☒ *IMPROVEMENT PERMIT w / site plan valid for 60 mos.* ☒ *AUTHORIZATION TO CONSTRUCT valid for period equal to IMPROVEMENT PERMIT-not to exceed 60 mo.*

Owner / Applicant Signature: Cindy Robinson Date 5-23-12

Improvement Permit by: [signature] Date 5-2-12

Authorization to Construct by: [signature] Date 5-2-12

Installed by: A-1 Backhoe

Operation Permit by: [signature] Date: 1-22-13

Existing System Inspected by: ____ Date: ____

YOU SHOULD CONTACT A LOCATOR SERVICE PRIOR TO ANY EXCAVATION.

WHITE COPY Environmental Health YELLOW COPY (Final) Owner / Applicant PINK COPY (Initial) Owner / Applicant