IREDELL COUNTY HEALTH DEPARTMENT

THIS PERMIT REPLACES EXISTING SYSTEM CHECK ON 11-13-02

STATESVILLE 704-878-5305 MOORESVILLE 704-664-5281

IMPROVEMENT PERMIT / AUTHORIZATION TO CONSTRUCT / OPERATION PERMIT / EXISTING SYSTEM INSPECTION

PERMIT# 109698 PIN# 4720-06-2065 DATE 11-1-03

OWNER OR CONTRACTOR BETHEL BAPTIST CHURCH PHONE: Business % 828-443-9311 ~~Home~~ % 828-437-4141

ADDRESS 1162 E. MONBO ROAD, STATESVILLE, NC 28677

LOCATION OLD MOUNTAIN ROAD TO EAST MONBO ROAD, CHURCH ON RIGHT ACROSS FROM ST. JOHN'S ROAD

SUBDIVISION GREASE TRAP 1000 GAL BLOCK / SECTION 1007 LOT 10-16-03 T-T LOT AREA 6.03 ACRES SITE CLASS: PS DESIGN FLOW 1040 L.T.A.R. EXISTING

Septic Tank: 2000 Gallons; STB 663 Date 1-26-03

Pump Tank: 2000 Gallons; PT 297 Date 12-17-03

Pump Make: ZOELLER 1800 Model BN153A Serial No.

Nitrification Field: No Fields TWO Square Feet Linear Feet EXISTING

No Lines EXISTING Trench Width Max Trench Bottom Depth Gravel Depth EXISTING

☑ New System ☐ Repair System Type: I II III IV V VI

System Description: CONVENTIONAL, GRAVITY

Repair System Description:

Maintenance Agreement Required: ☐ Yes ☑ No

☐ House/Mod. Home No. Bedrooms

☐ Mobile Home No. Bathrooms

☐ Business No. Employees

☑ Other CHURCH @ 208 SEATS PLUS KITCHEN


☐ Slab ☐ Crawl Space ☑ Basement w/plumbing ☐ Basement wo/plumbing

Water Supply: ☐ Individual ☐ Public ☑ Community WELL

Comments/Conditions: ① INSTALL THREE NEW TANKS AS SHOWN. ② DIVERT EXISTING COLLECTION SEWER INTO NEW SEPTIC TANK. NEW 2000 GAL SEPTIC TANK

Comments/Conditions: ③ SEE ATTACHED SHEET FOR PUMP TANK DIAGRAM & PUMP REQUIREMENTS. ④ USE 3" SCH-80 PVC SUPPLY LINE. ⑤ KEEP TANKS MINIMUM TEN (10) FEET FROM PROPERTY LINE.

INITIAL SITE SKETCH

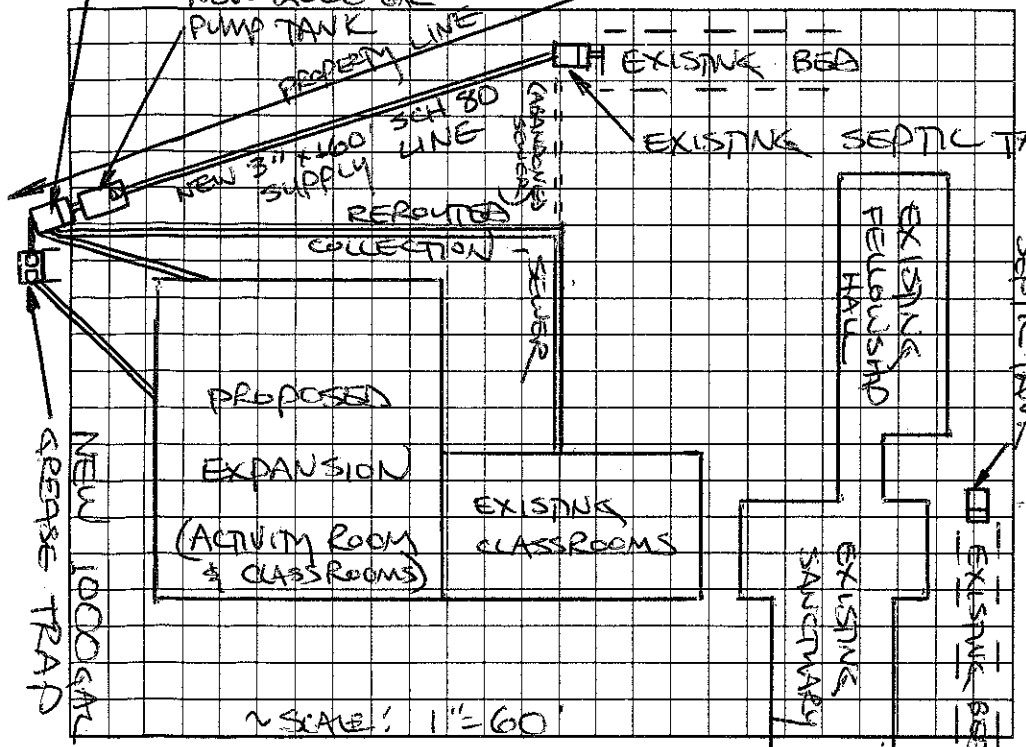

AS BUILT SKETCH

① GREASE TRAP INSTALLED WITH RISERS USING TUF-TITE FILTER

② SEPTIC TANK WITH RISERS INSTALLED USING ZABEL A-300 FILTER

Permit can be suspended or revoked if any false information is supplied toward securing the permit/any unauthorized changes are made to the site/any unauthorized changes are made in the installation of the system. Improvement Permit with plat valid without expiration. Improvement Permit with site plan valid for sixty months. Authorization to Construct is valid for a period equal to that of Improvement Permit – not to exceed sixty months.

Signed: [signature] date 11-4-03 Installed by: G & M ENT. ?

Improvement Permit by: STEVE HENDRICK date 11-1-03 Operation Permit by: E H North date 11-1-08

Authorization to Construct by: STEVE HENDRICK date 11-1-03 Existing System Inspection by: date

HEALTH DEPT. COPY: WHITE OWNER COPY (FINAL): YELLOW OWNER COPY (INITIAL): PINK