IREDELL COUNTY HEALTH DEPARTMENT

STATESVILLE 704-878-5305 (C1) MOORESVILLE 704-664-5281

IMPROVEMENT PERMIT / AUTHORIZATION TO CONSTRUCT / OPERATION PERMIT / EXISTING SYSTEM INSPECTION

PERMIT# 116154 PIN# 4720-05-5616 DATE 10-15-03

OWNER OR CONTRACTOR IVAN WOODLE PHONE: Business Home 704-528-6471

ADDRESS 106 ST. JOHNS ROAD, STATESVILLE, NC 28677

LOCATION OLD MOUNTAIN ROAD TO EAST MONBO ROAD, TL ST. JOHNS ROAD, 1ST HOUSE ON RIGHT

SUBDIVISION BLOCK / SECTION LOT LOT AREA 0.34 ACRE SITE CLASS PS DESIGN FLOW 240 L.T.A.R. EXISTING

Septic Tank: 1000 Gallons; STB 1007 Date 9-2-03
Pump Tank: Gallons; PT Date
Pump Make: Model Serial No.
Nitrification Field: No Fields 1 Square Feet — Linear Feet EXISTING
No Lines — Trench Width — Max Trench Bottom Depth — Gravel Depth —

☑ New System ☐ Repair System Type: I, II, III, IV, V, VI
System Description: CONVENTIONAL, GRAVITY
Repair System Description:
Maintenance Agreement Required: ☐ Yes ☑ No

☑ House/Mod. Home No. Bedrooms 2
☐ Mobile Home No. Bathrooms 1
☐ Business No. Employees
☐ Other


☐ Slab ☑ Crawl Space ☐ Basement w/plumbing ☐ Basement wo/plumbing

Water Supply: ☑ Individual ☐ Public ☐ Community WELL

Comments:/Conditions: CRUSH & FILL EXISTING SEPTIC TANK

Comments:/Conditions: SEPTIC TANK WITH MARKER INSTALLED USING "TUFTITE" FILTER

INITIAL SITE SKETCH

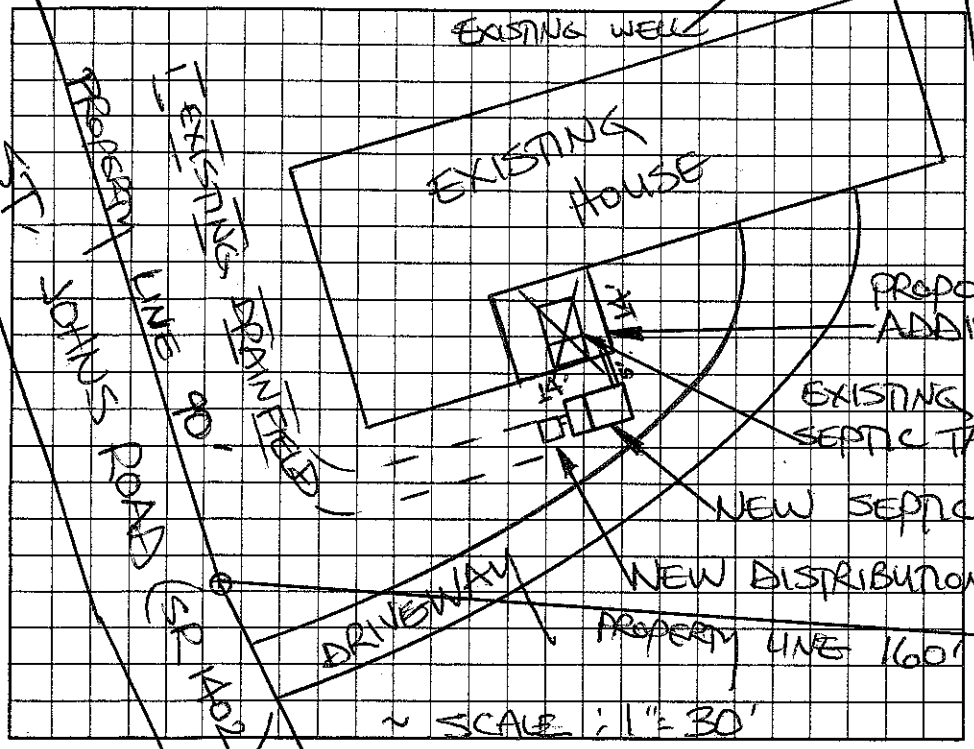

AS BUILT SKETCH

SYSTEM INSTALLED ACCORDING TO INITIAL SITE SKETCH

Permit can be suspended or revoked if any false information is supplied toward securing the permit/any unauthorized changes are made to the site/any unauthorized changes are made in the installation of the system. Improvement Permit with plat valid without expiration. Improvement Permit with site plan valid for sixty months. Authorization to Construct is valid for a period equal to that of Improvement Permit – not to exceed sixty months.

Signed: I. W. Woodle date 10-15-03 Installed by: JAMES HUDLER

Improvement Permit by: STEVE HEDRICK date 10-15-03 Operation Permit by: STEVE HEDRICK date 10-30-03

Authorization to Construct by: STEVE HEDRICK date 10-15-03 Existing System Inspection by: date

HEALTH DEPT. COPY: WHITE OWNER COPY (FINAL): YELLOW OWNER COPY (INITIAL): PINK