IREDELL COUNTY HEALTH DEPARTMENT

STATESVILLE 704-878-5305 MOORESVILLE 704-664-5281 (1)

IMPROVEMENT PERMIT / AUTHORIZATION TO CONSTRUCT / OPERATION PERMIT / EXISTING SYSTEM INSPECTION

PERMIT# 119426 PIN# 4720-05-5616 DATE 3-5-04

OWNER OR CONTRACTOR JEFFREY CAMPBELL PHONE: Business 704-528-6471 Home 704-528-3916

ADDRESS 137 PHEASANT RUN RD, TROUTMAN NC 28166

LOCATION OLD MOUNTAIN ROAD TO EAST MONBO ROAD, TL ST. JOHN'S ROAD 1ST HOUSE ON RIGHT AT #106

SUBDIVISION _____ BLOCK / SECTION _____ LOT _____ LOT AREA 0.34 ACRE SITE CLASS. PS DESIGN FLOW 240 L.T.A.R. EXISTING

Septic Tank: 1000 Gallons; STB 1007 Date 9-2-03
Pump Tank: _____ Gallons; PT _____ Date _____
Pump Make: _____ Model _____ Serial No. _____
Nitrification Field: No Fields 1 Square Feet _____ Linear Feet EXISTING
No Lines BED Trench Width _____ Max Trench Bottom Depth _____ Gravel Depth EXISTING

☐ New System ☐ Repair System Type: (II) III, IV, V, VI
System Description: CONVENTIONAL, GRAVITY
Repair System Description: _____
Maintenance Agreement Required: ☐ Yes ☑ No

☑ House/Mod. Home No. Bedrooms 2
☐ Mobile Home No. Bathrooms 1
☐ Business No. Employees _____
☐ Other _____


☐ Slab ☑ Crawl Space ☐ Basement w/plumbing ☐ Basement wo/plumbing

Water Supply:
☑ Individual
☐ Public
☐ Community
WELL


Comments:/Conditions:

Comments:/Conditions:

INITIAL SITE SKETCH

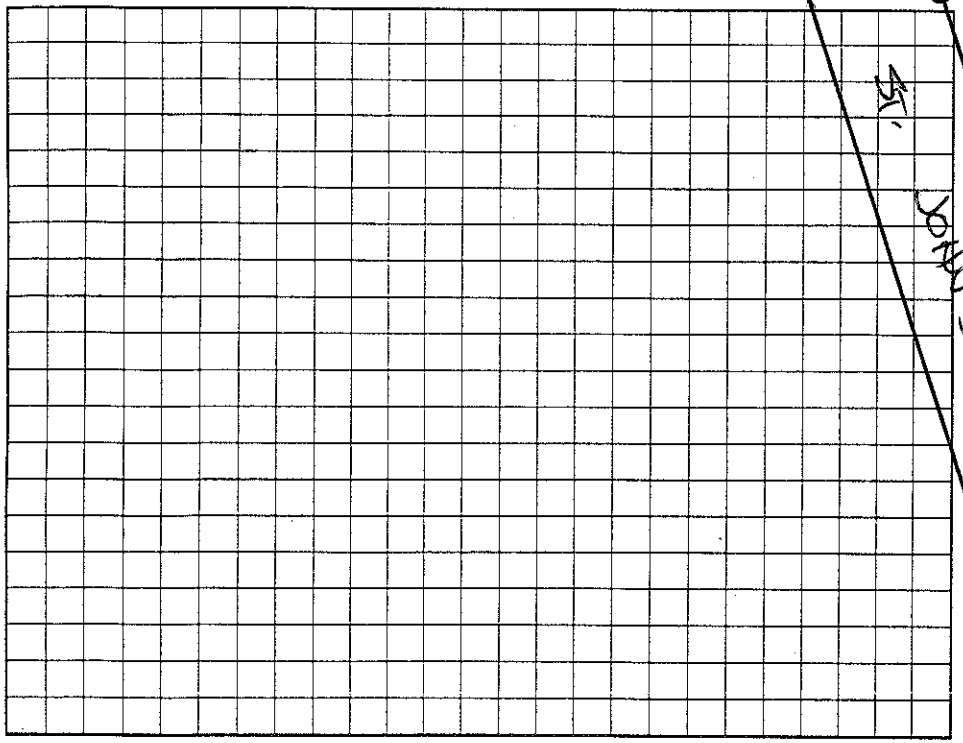

AS-BUILT SKETCH

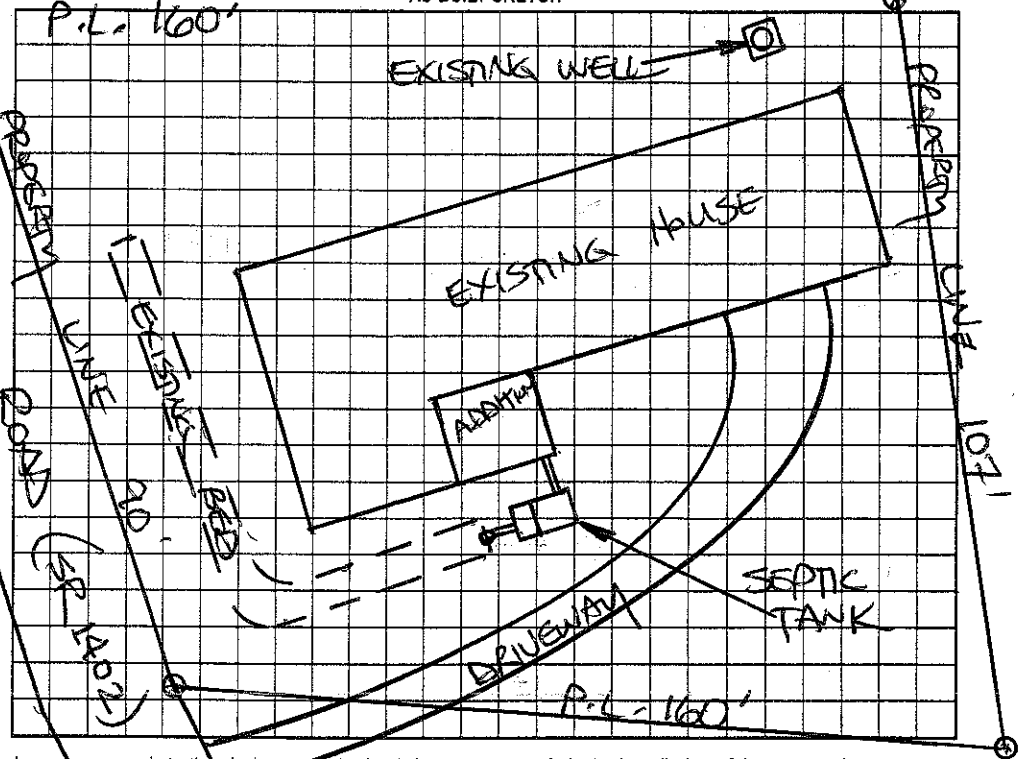

Permit can be suspended or revoked if any false information is supplied toward securing the permit/any unauthorized changes are made to the site/any unauthorized changes are made in the installation of the system. Improvement Permit with plat valid without expiration. Improvement Permit with site plan valid for sixty months. Authorization to Construct is valid for a period equal to that of Improvement Permit – not to exceed sixty months.

Signed: _____ date _____ Installed by: _____

Improvement Permit by: _____ date _____ Operation Permit by: _____ date _____

Authorization to Construct by: _____ date _____ Existing System Inspection by: STEVE HENDRICK date 3-5-04

HEALTH DEPT. COPY: WHITE OWNER COPY (FINAL): YELLOW OWNER COPY (INITIAL): PINK

E. MONBO RD (SR 1328)