IREDELL COUNTY HEALTH DEPARTMENT

Statesville Phone TR 3-7271 Mooresville Phone NO 3-1271

PERMIT TO INSTALL SEPTIC TANK

Permit No. 11 Permit Date 7-26 1972

Owner Bethel Baptist Church Address Statesville N.C.

Installed By Sam Aswalt Address Troutman N.C.


Location of Property East Mombo

Tank		Capacity		Length of Lines		Fixtures	
Block	( )	1000	(✓)	225'	(✓)	No. of Baths	( )
Precast	(✓)	1250	( )	250'	( )	Dishwasher	( )
		1500	( )	Other		Garbage Grdr.	( )
		Other				Other	

NOTIFY HEALTH DEPARTMENT AT LEAST EIGHT HOURS BEFORE TANK IS TO BE INSPECTED.

Final Inspection 7-26 1972 Approved (✓) Disapproved ( )

Remarks Lines 100'+ from Well

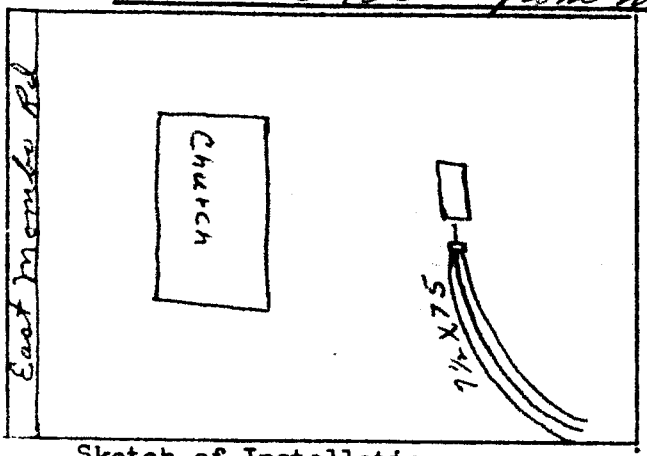

Sketch of Installation

E. G. Stevenson

Sanitarian