IREDELL COUNTY HEALTH DEPARTMENT

STATESVILLE 704-878-5305 (2nd) MOORESVILLE 704-664-5281 (2)

IMPROVEMENT PERMIT / AUTHORIZATION TO CONSTRUCT / OPERATION PERMIT / EXISTING SYSTEM INSPECTION

PERMIT # 156384 PIN # 4720097789 DATE 6-08-09

OWNER or APPLICANT ELENA CLAYTON PHONE: Business 704 878 9541 Home: 8286328074

OWNER or APPLICANT ADDRESS 35 SPRINGS MTN LANE STATESVILLE NC 28625

LOCATION / DIRECTIONS EAST MAUBO (2) Pineville (2) KOI ON RT IN WOODS

SUBDIVISION _____ BLOCK / SECTION _____ LOT # _____ LOT AREA 3.192 DESIGN FLOW 480 L.T.A.R. .3

Septic Tank 1000 Gallons: STB 1012 Date 2-19-10
Pump Tank _____ Gallons: PT _____ Date _____
Pump Make _____ Model _____ Serial # _____
Nitrification Field No Fields ____ No Lines 4 Linear Feet 533'
Trench Width 36" Max. Trench Bottom Depth 36" Gravel Depth 12"

☒ New System ☐ Repair ☐ Expansion System Type I (II) III IV V VI
System Description: GRAVITY CONVENTIONAL
Repair System Description: SAME
Maintenance Agreement Required ☐ YES ☒ NO
☒ GRAVITY ☐ PRESSURE

☒ Residence No. Bedrooms 4
☐ Business No. Persons ____
☐ Other No. Employees ____
☐ Slab ☐ Crawl Space
☒ Basement w/plumbing ☐ Basement w/o plumbing

Water Supply: ☒ Private ☐ Public ☐ Community

Comments / Conditions (1) System Sized 4 A 4 BEDROOM HOME ONLY PLACED ON A 3 BEDROOM HOME. (2) The 2 supply lines must enter the tank in 2 seperate locations. (3) System is completely flossed out. (4) An ACCEPTED SYSTEM

INITIAL SITE SKETCH

SEE ATTACHED SYSTEM DESIGN BY LORNE COOK, R.S.

Comments / Conditions CAN BE USED. (5) Install Lines on contours & maintain setbacks (6) Install 4 Lines 133' LONG USING 4 Drop Boxes AS DRAWN (7) DRAWING & TIME THE TRENCH WALLS OF TRENCHES

AS BUILT SKETCH

INSTALLED AS BIO DIFFUSER ARC 36 Center-Fed 400 IF. Shown on S.H. plan.

Permit can be suspended or revoked if any false information is supplied toward securing the permit / any unauthorized changes are made to the site / any unauthorized changes are made in the installation of the system.

☐ *IMPROVEMENT PERMIT w / plat valid without expiration.* ☒ *IMPROVEMENT PERMIT w / site plan valid for 60 mos.* ☒ *AUTHORIZATION TO CONSTRUCT valid for period equal to IMPROVEMENT PERMIT-not to exceed 60 mo.*

Owner / Applicant Signature: Elena E Clayton Date 6-11-09

Improvement Permit by: _____ Date 6-8-09

Authorization to Construct by: _____ Date 6-8-09

YOU SHOULD CONTACT A LOCATOR SERVICE PRIOR TO ANY EXCAVATION.

Installed by: Ground breakers

Operation Permit by: Jim Nygen, R.S. Date: 9 Nov. 10

Existing System Inspected by: _____ Date: _____

WHITE COPY Environmental Health YELLOW COPY (Final) Owner / Applicant PINK COPY (Initial) Owner / Applicant

A Survey for


KENNETH E. EVERTON and

LESSIE C. EVERTON


Their Property, and Lying in

FALLSTOWN TOWNSHIP IREDELL COUNTY
NORTH CAROLINA
PINs: 4720 09 7789 DEEDs: 1638-611
4721 00 9022 582-200
DATE: 02-27-2009 SCALE: 1" = 100'
DRAWING No. 022709a DRAWN by JWR

This property is NOT in a FLOOD HAZARD AREA.

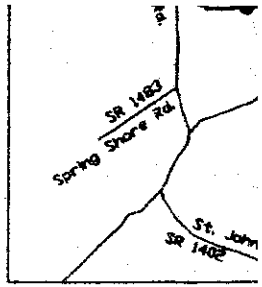

Vicinity Map

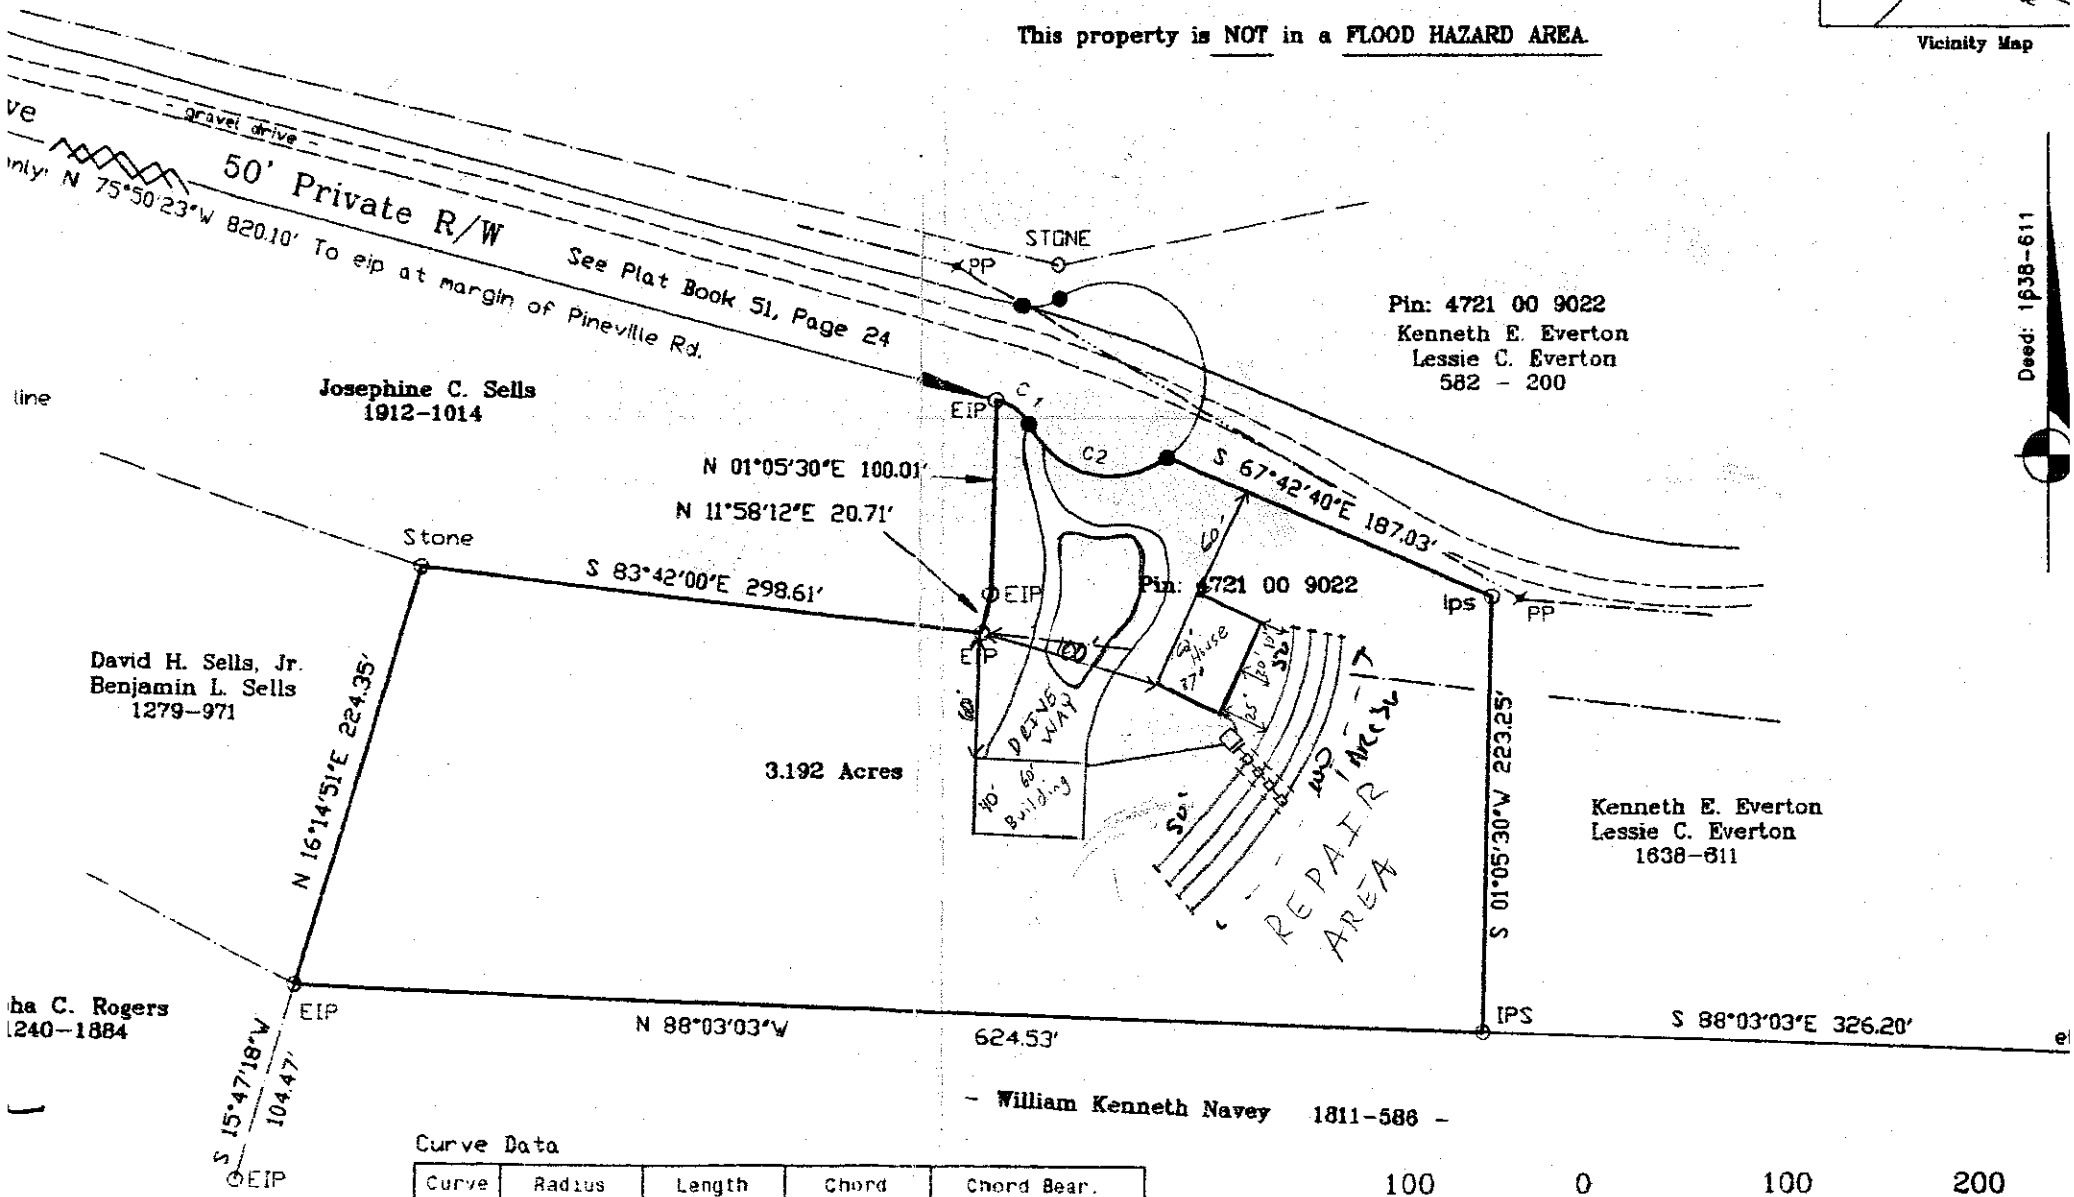

- William Kenneth Navey 1811-586 -

Curve Data

Curve	Radius	Length	Chord	Chord Bear.
C1	25.00'	21.03'	20.41	S 51 44 41" E
C2	50.00'	85.68'	75.57	S 76 44 25" E

100 0 100 200
GRAPHIC SCALE - FEET