Site address is: 159 Clark Cove Rd - Stat.

IREDELL COUNTY HEALTH DEPARTMENT

STATESVILLE 704-878-5305 MOORESVILLE 704-664-5281

IMPROVEMENT PERMIT / AUTHORIZATION TO CONSTRUCT @ OPERATION PERMIT / EXISTING SYSTEM INSPECTION

PERMIT # 171832 PIN # 4720-12-6937 DATE APRIL 25 2012

OWNER or APPLICANT LARRY McCOURT PHONE: Business Home: 704-528-8019

OWNER or APPLICANT ADDRESS 127 BARGATE DR, STATESVILLE NC 28677

LOCATION / DIRECTIONS ST. JOHN'S ROAD TO CLARK COVE ROAD LOT ON LEFT ~ 0.25 MILE

SUBDIVISION BLOCK / SECTION LOT # LOT AREA 1.669 AC DESIGN FLOW 360 L.T.A.R. 0.25 GPD/FT²

Septic Tank 1000 Gallons: STB Date

Pump Tank Gallons: P T Date

Pump Make Model Serial #

Nitrification Field No Fields 1 No Lines 4 Linear Feet 360

Trench Width 36" Max. Trench Bottom Depth 36" Gravel Depth N/A

☑ New System ☐ Repair ☐ Expansion System Type I II III IV V VI

System Description: 25% REDUCTION, GRAVITY

Repair System Description: 25% REDUCTION, GRAVITY

Maintenance Agreement Required ☐ YES ☑ NO

☑ GRAVITY ☐ PRESSURE

☐ Residence No. Bedrooms 3

☐ Business No. Persons

☐ Other No. Employees

☐ Slab ☑ Crawl Space


☐ Basement w/plumbing ☐ Basement w/o plumbing

Water Supply ☑ Private WELL ☐ Public ☐ Community

Comments / Conditions: INSTALL 25% REDUCTION SYSTEM ON CONTOUR AS SHOWN BELOW,

Comments / Conditions

INITIAL SITE SKETCH

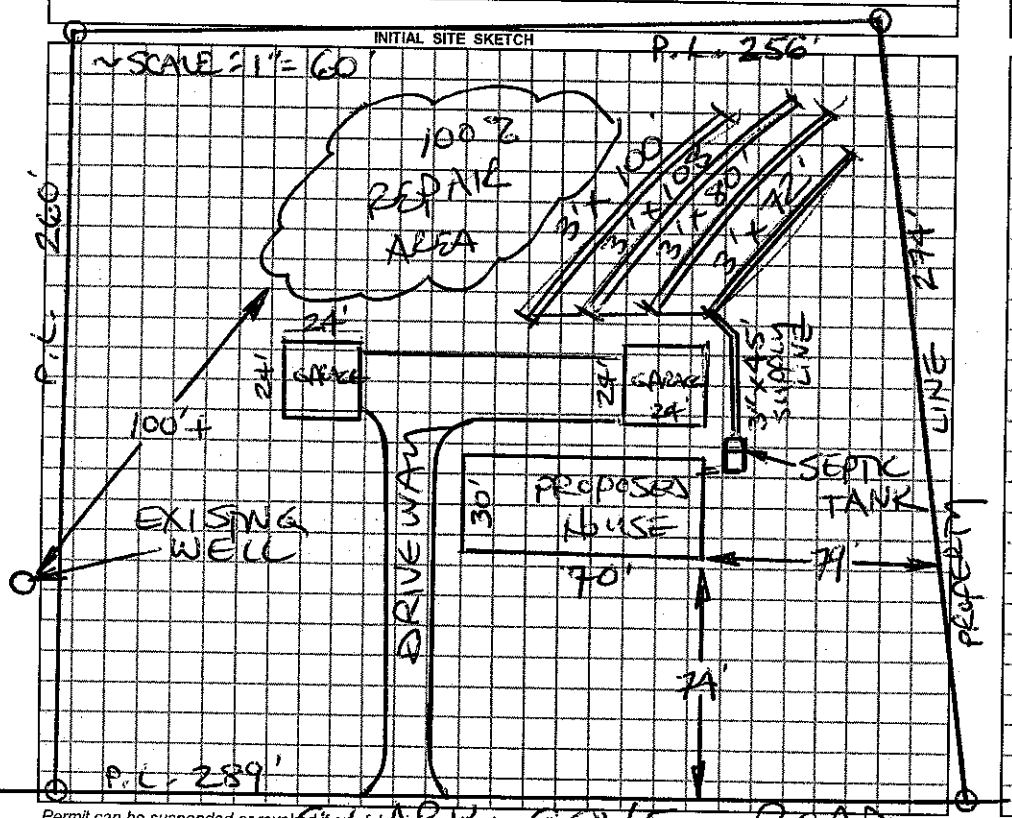

AS BUILT SKETCH

Location of the proposed STORAGE BUILDING addition does not appear to impact the existing on-site septic system.**NOTE:

R. STEVE HEDRICK REHS

Date: OCTOBER 29, 2012

ICHD-Environmental Health Division

Permit can be suspended or revoked if any false information is supplied toward securing the permit, any unauthorized changes are made to the site / any unauthorized changes are made in the installation of the system.

☐ *IMPROVEMENT PERMIT w / plat valid without expiration.* ☐ *IMPROVEMENT PERMIT w / site plan valid for 60 mos.* ☐ *AUTHORIZATION TO CONSTRUCT valid for period equal to IMPROVEMENT PERMIT-not to exceed 60 mo.*

Owner / Applicant Signature: Larry McCourt Date 4-25-12

Improvement Permit by: STEVE HEDRICK Date 4-25-12

Authorization to Construct by: Date 4-25-12

Installed by:

Operation Permit by: Date:

Existing System Inspected by: Date:

YOU SHOULD CONTACT A LOCATOR SERVICE PRIOR TO ANY EXCAVATION.

WHITE COPY Environmental Health YELLOW COPY (Final) Owner / Applicant PINK COPY (Initial) Owner / Applicant