IREDELL COUNTY HEALTH DEPARTMENT - *ENVIRONMENTAL HEALTH* ☒ STATESVILLE OFFICE 704-878-5305 ☐ MOORESVILLE OFFICE 704-664-5281

IMPROVEMENT PERMIT / AUTHORIZATION TO CONSTRUCT / OPERATION PERMIT / EXISTING SYSTEM INSPECTION

PERMIT # 174031 PIN # 4720136324 DATE 9-25-12

OWNER Eric Estes APPLICANT: Eric Estes PHONE: Home/Cell # 704-528-6577 Business # N/A

SITE ADDRESS 144 Clark Cove Rd. OWNER / APPLICANT ADDRESS 144 Clark Cove Rd.

SITE DIRECTIONS 215 TR Old Mtn Rd. TL East Monbo Rd TL St Johns Rd TR Clark Cove Rd.

SUBDIVISION N/A BLOCK / SECTION N/A LOT # N/A LOT AREA 0.541 acres DESIGN FLOW 480 gpd L.T.A.R. 0.3

Septic Tank 1600 Gallons: STB 760 Date 10-8
Pump Tank ____ Gallons: P T ____ Date ____
Pump Make ____ Model ____ Serial # ____
No. Nitrification Fields: 1 No. Lines 3 Linear Feet 200
Trench Width 36" Max. Trench Bottom Depth 36" Gravel Depth N/A

☐ New System ☐ Repair ☑ Expansion System Type I II ☒ III IV V VI
System Description: 25% Reduction
Repair System Description: 25% Reduction
Maintenance Agreement Required ☐ YES ☒ NO
☒ GRAVITY ☐ PRESSURE


☒ Residence No. Bedrooms 4
☐ Business No. Persons ____
☐ Other No. Employees ____
☐ Slab ☐ Crawl Space
☐ Basement w/plumbing ☑ Basement w/o plumbing

Water Supply: ☑ Private ☐ Public ☐ Community


Comments / Conditions: Improvements ONLY. Properly abandon existing well & submit a floor plan prior to issuance of CP. Install a 25% Reduction system on contour with serial distribution & connect to existing septic system as shown in drawing

- Obtain Well Abandonment permit, prior to doing work, from Iredell Co.

INITIAL SITE SKETCH

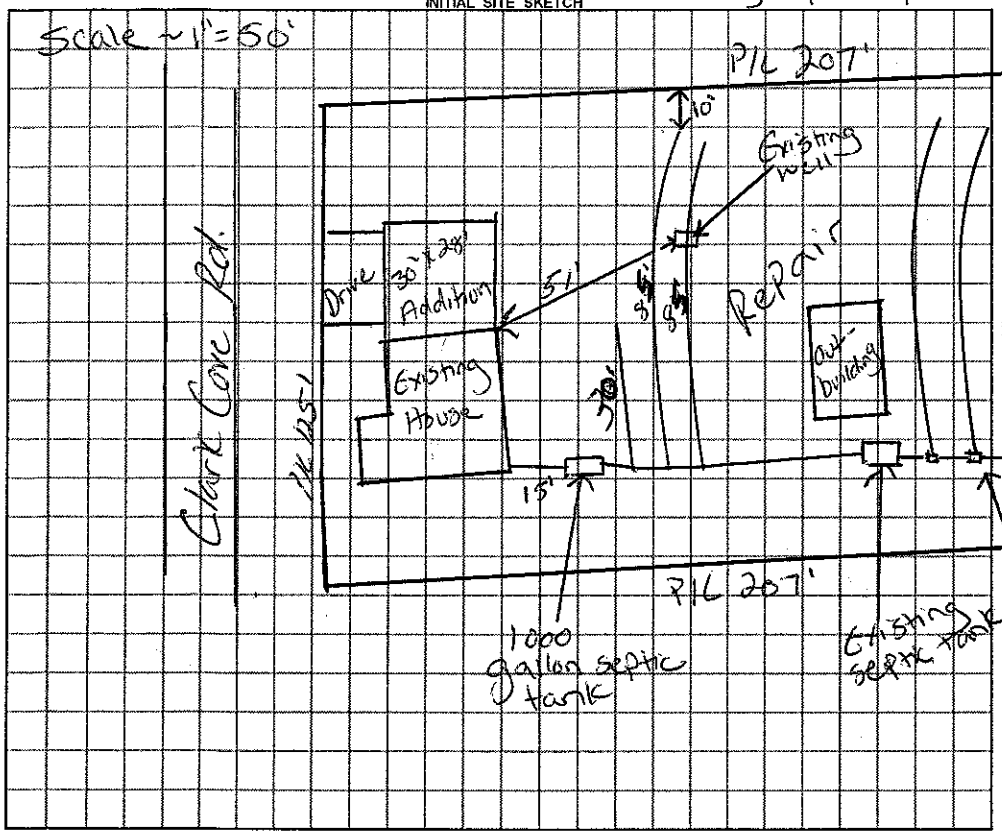

AS BUILT SKETCH

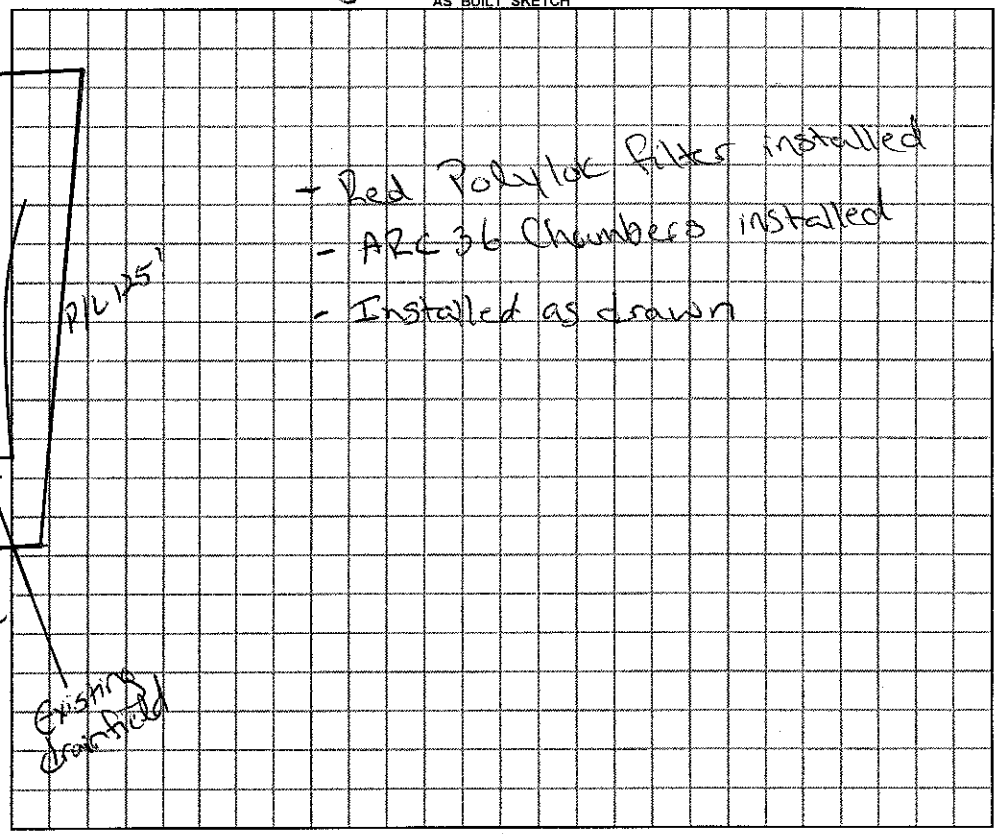

Permit can be suspended or revoked if any false information is supplied toward securing the permit / any unauthorized changes are made to the site / any unauthorized changes are made in the installation of the system.

☐ ***IMPROVEMENT PERMIT*** with plat valid without expiration. ☒ ***IMPROVEMENT PERMIT*** with ~~plat valid without expiration.~~ site plan valid 60 mo. ☐ ***AUTHORIZATION TO CONSTRUCT*** valid for period equal to IMPROVEMENT PERMIT--not to exceed 60 mo.

Owner / Applicant Signature: Eric Estes Karen Haagmon 12-14-12 Date 11-20-12 Installed by: A1 Backhoe

IMPROVEMENT PERMIT by: Justin Mendenhall REHS Date 9-25-12 OPERATION PERMIT by: Justin Mendenhall REHS Date 12-19-12

AUTHORIZATION TO CONSTRUCT by: Justin Mendenhall REHS Date 12-14-12 Existing System Inspected by: ____ REHS Date ____

YOU SHOULD CONTACT A LOCATOR SERVICE PRIOR TO ANY EXCAVATION

White Copy -- Environmental Health YELLOW COPY (Final) Owner / Applicant PINK COPY (Initial) Owner / Applicant