IREDELL COUNTY HEALTH DEPARTMENT

Statesville Office (704) 878-5305 Mooresville Office (704) 660-3625 PERMIT # 212801

IMPROVEMENT PERMIT / AUTHORIZATION TO CONSTRUCT / OPERATION PERMIT / EXISTING SYSTEM

PIN # 4720140985

APPLICANT: William Yeckley APPLICANT ADDRESS: 148 Park Terrace

SITE ADDRESS: 146 St. Johns Rd. - Statesville PHONE: 704-902-3980 ALT. PHONE: N/A

SITE DIRECTIONS: Old Mtn Rd to G. Manbo Rd. TL St. Johns Rd.

SUBDIVISION: N/A SECTION: N/A LOT # N/A LOT AREA: 3.13 acres DESIGN FLOW: Existing L.T.A.R.: Existing

Septic Tank Existing (gal) STB Date

Pump Tank (gal) PT Date

Pump Make Model Serial #

Nitrification Fields Ex # Lines Ex Linear Ft: Ex

Trench Width Ex Max. Trench Bottom Depth Ex Gravel Depth Ex

☐ New System ☐ Repair ☐ Expansion System Type: I II III IV V VI

System Description: Existing

Repair System Description:

Maintenance Agreement Required: ☐ YES ☐ NO

☑ GRAVITY ☐ PRESSURE

☐ Residence No. Bedrooms Ex

☐ Business No. Persons

☑ Other Church No. Employees

☐ Slab ☐ Crawl Space


☐ Basement w/plumbing ☐ Basement w/o plumbing

Water Supply: ☐ Private ☑ Public well ☐ Community


Comments / Conditions:

- Maintain a minimum of 5' between proposed building foundation & all components of septic tank system. Maintain a minimum of 25' between proposed Building & existing well.

INITIAL SITE SKETCH

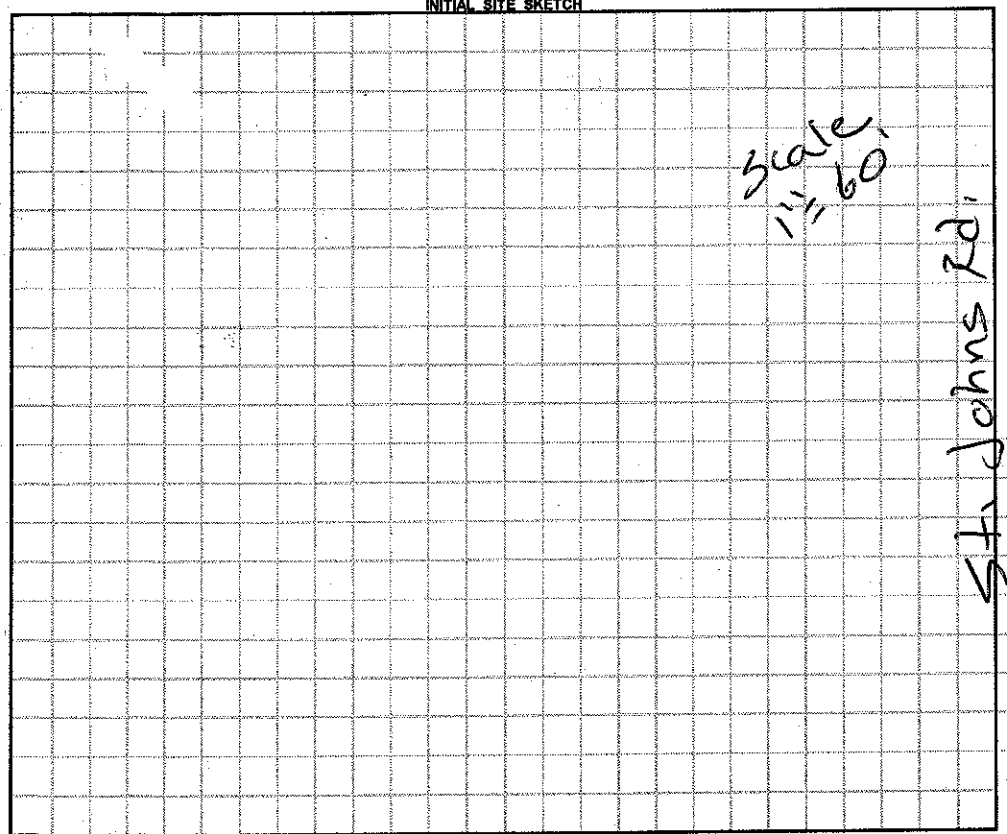

AS BUILT SKETCH

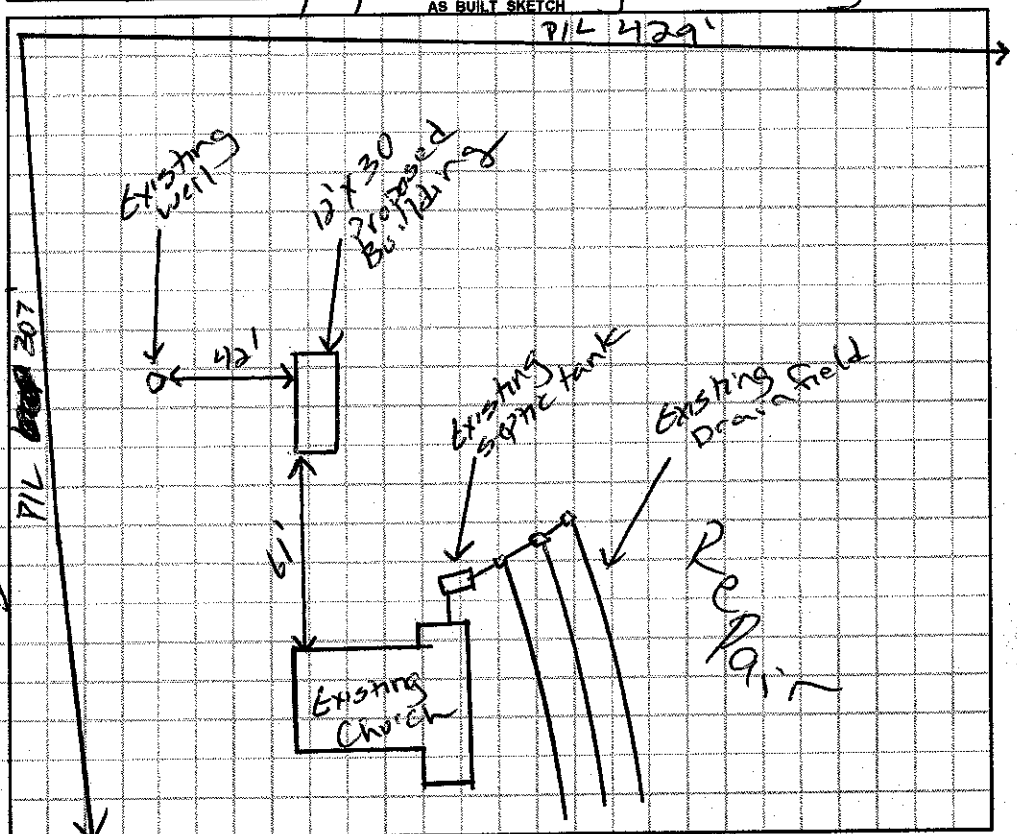

Permit can be suspended or revoked if any false information is supplied toward securing the permit / any unauthorized changes are made to the site / any unauthorized changes are made in the installation of the system. **CONTACT A LOCATOR SERVICE PRIOR TO ANY EXCAVATION**

☐ **IMPROVEMENT PERMIT** *with plat valid without expiration.* ☐ **IMPROVEMENT PERMIT** *with site plan valid for 60 mos.* ☐ **AUTHORIZATION TO CONSTRUCT** *valid for period equal to IMPROVEMENT PERMIT--not to exceed 60 mo.*

Owner / Applicant Signature: Issued w/o Signature 9/8/15 Date:

Installed by:

IMPROVEMENT PERMIT by: Date:

OPERATION PERMIT by: Date:

AUTHORIZATION TO CONSTRUCT by: Date:

Existing System Inspected by: Justin Henderson Date: 9-7-15

Health Dept. Copy - WHITE Applicant (Final Approval) - YELLOW Applicant (Conditional Approval) - PINK