IREDELL COUNTY HEALTH DEPARTMENT - *ENVIRONMENTAL HEALTH* ☒ STATESVILLE OFFICE 704-878-5305 ☐ MOORESVILLE OFFICE 704-664-5281

IMPROVEMENT PERMIT / AUTHORIZATION TO CONSTRUCT / OPERATION PERMIT / EXISTING SYSTEM INSPECTION

PERMIT # 172034 PIN # 4720398108 DATE 6-15-12

OWNER Pinecrest Land Development APPLICANT: Frank Palmer PHONE: Home/Cell # 704-902-6033 Business #

SITE ADDRESS 905 East Monbo Rd. OWNER / APPLICANT ADDRESS

SITE DIRECTIONS Hwy 40W to south on Old Mtn. Rd. (R) on East Monbo, property on corner of E. Monbo and Hudspeth

SUBDIVISION Pinecrest BLOCK / SECTION LOT # 4 LOT AREA 1.4 Acre DESIGN FLOW 480 L.T.A.R. .3

Septic Tank 1000 Gallons: STB 825 Date 9-6-12
Pump Tank Gallons: P T Date
Pump Make Model Serial #
No. Nitrification Fields: 1 No. Lines 4 Linear Feet 400
Trench Width 36" Max. Trench Bottom Depth 36" Gravel Depth n/a

☒ New System ☐ Repair ☐ Expansion System Type I II III IV V VI
System Description: 25% Reduction Gravity
Repair System Description: 50% Reduction ~~Gravity~~ LP
Maintenance Agreement Required ☐ YES ☒ NO
☒ GRAVITY ☐ PRESSURE


☒ Residence No. Bedrooms 4
☐ Business No. Persons
☐ Other No. Employees
☐ Slab ☒ Crawl Space
☐ Basement w/plumbing ☐ Basement w/o plumbing

Water Supply: ☒ Private ☐ Public ☐ Community


Comments / Conditions: Electric pole to be relocated if necessary

Poly lock

INITIAL SITE SKETCH

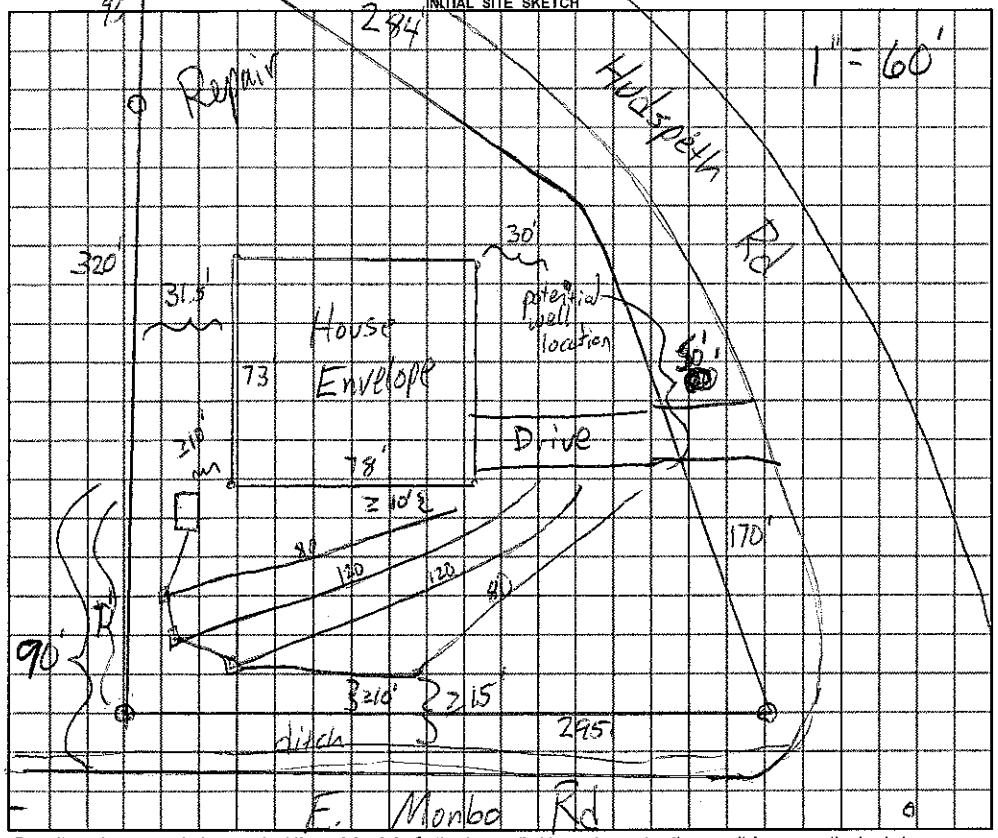

AS BUILT SKETCH

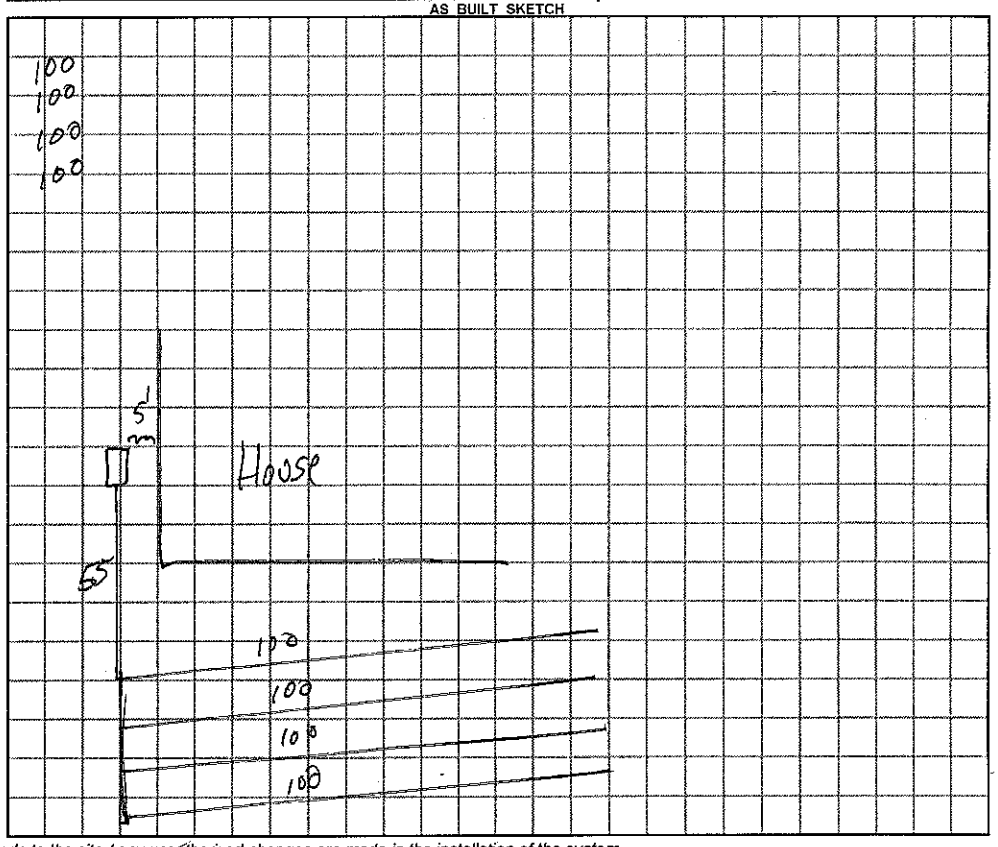

Permit can be suspended or revoked if any false information is supplied toward securing the permit / any unauthorized changes are made to the site / any unauthorized changes are made in the installation of the system.

☐ ***IMPROVEMENT PERMIT*** with plat valid without expiration ☒ ***IMPROVEMENT PERMIT*** with plat valid without expiration. site plan valid 60 mo. ☒ ***AUTHORIZATION TO CONSTRUCT*** valid for period equal to IMPROVEMENT PERMIT–not to exceed 60 mo.

Owner / Applicant Signature: Date 6-15-12 Installed by: Rowan

IMPROVEMENT PERMIT by: REHS Date 6-15-12 OPERATION PERMIT by: REHS Date 10-25-12

AUTHORIZATION TO CONSTRUCT by: REHS Date 6-15-12 Existing System Inspected by: REHS Date

YOU SHOULD CONTACT A LOCATOR SERVICE PRIOR TO ANY EXCAVATION

White Copy – Environmental Health YELLOW COPY (Final) Owner / Applicant PINK COPY (Initial) Owner / Applicant