11:30

# IREDELL COUNTY HEALTH DEPARTMENT

STATESVILLE 704-878-5305 MOORESVILLE 704-664-5281

## IMPROVEMENT PERMIT / AUTHORIZATION TO CONSTRUCT / OPERATION PERMIT / EXISTING SYSTEM INSPECTION

PERMIT# REPAIR PIN# REPTEK DATE 11/15/00

OWNER OR CONTRACTOR 644 SHOEMAKER PHONE: Business 528-6733 Home

ADDRESS 892 E MOMBO RD

LOCATION OLD MOUNTAIN RD. TR E MOMBO RD. ~ 3 MILES ON RT # 892

SUBDIVISION R- BLOCK / SECTION — LOT — LOT AREA SITE CLASS. PS DESIGN FLOW 360GPD L.T.A.R. .3

Septic Tank: EXISTING Gallons: STB Date

Pump Tank: Gallons: PT Date

Pump Make: Model Serial No.

Nitrification Field: No Fields 1 Square Feet 900 Linear Feet 300

No Lines 4@75' Trench Width 36" Max Trench Bottom Depth 36" Gravel Depth 12"

☐ New System ☑ Repair System Type: I (II) III, IV, V, VI

System Description:

Repair System Description: GRAVITY CONVENTIONAL

Maintenance Agreement Required: ☐ Yes ☑ No

☑ House/Mod. Home No. Bedrooms 2

☐ Mobile Home No. Bathrooms 2

☐ Business No. Employees

☐ Other


☐ Slab ☑ Crawl Space ☐ Basement w/plumbing ☐ Basement wo/plumbing

Water Supply: ☑ Individual ☐ Public ☐ Community

Comments./Conditions:

Comments./Conditions:

INITIAL SITE SKETCH

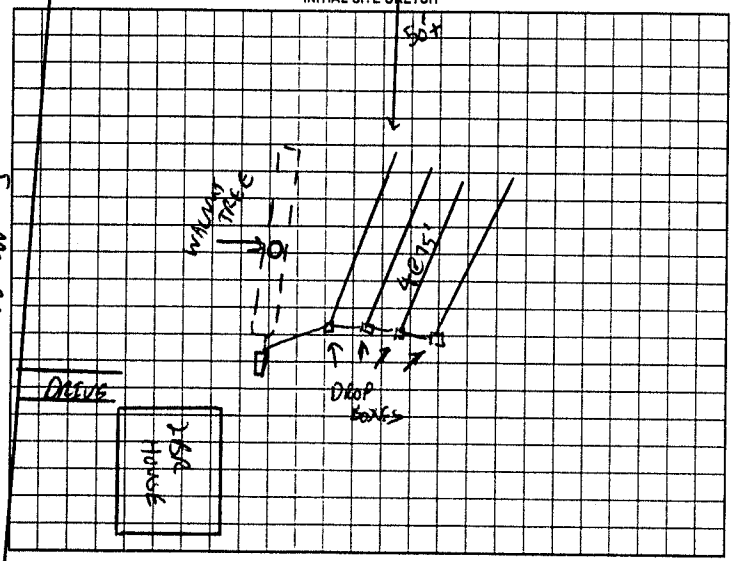


AS BUILT SKETCH

E. MOMBO

Permit can be suspended or revoked if any false information is supplied toward securing the permit/any unauthorized changes are made to the site/any unauthorized changes are made in the installation of the system. Improvement Permit with plat valid without expiration. Improvement Permit with site plan valid for sixty months. Authorization to Construct is valid for a period equal to that of Improvement Permit – not to exceed sixty months.

Signed: date

Improvement Permit by: date 11/15/00

Authorization to Construct by: date 11/15/00

Installed by: Wes Lytton

Operation Permit by: RSI date 11/30/00

Existing System Inspection by: date

HEALTH DEPT. COPY: WHITE OWNER COPY (FINAL): YELLOW OWNER COPY (INITIAL): PINK