IREDELL COUNTY HEALTH DEPARTMENT - *ENVIRONMENTAL HEALTH* ☐ STATESVILLE OFFICE 704-878-5305 ☐ MOORESVILLE OFFICE 704-664-5281

IMPROVEMENT PERMIT / AUTHORIZATION TO CONSTRUCT / OPERATION PERMIT / EXISTING SYSTEM INSPECTION

PERMIT # (not required) PIN # 4720-49-0239 DATE APRIL 17, 2012

OWNER MATTHEW R. TACIA APPLICANT: KATHERINE MUIR PHONE: Home/Cell # 508-527-4314 Business #

SITE ADDRESS 895 EAST MONBO ROAD OWNER / APPLICANT ADDRESS 165 HILLTOP LANE, MOORESVILLE NC 28

SITE DIRECTIONS OLD MOUNTAIN ROAD TO EAST MONBO ROAD, 3.0 MILES ON LEFT AT BOX #895

SUBDIVISION PINECREST ESTATES BLOCK / SECTION LOT # 3 LOT AREA 1.242 AC DESIGN FLOW 480 L.T.A.R. 0.25 GPD/FT²

Septic Tank 1000 Gallons: STB Date

Pump Tank 1000 Gallons: P T Date

Pump Make Model Serial #

No. Nitrification Fields: 1 No. Lines 4 Linear Feet 480

Trench Width 36" Max. Trench Bottom Depth 36" Gravel Depth N/A

☐ New System ☐ Repair ☐ Expansion System Type I II (III) V V VI

System Description: 25% REDUCTION PRESSURE MAN.

Repair System Description: 25% REDUCTION PRESSURE MAN.

Maintenance Agreement Required ☐ YES ☑ NO

☐ GRAVITY ☑ PRESSURE

☑ Residence No. Bedrooms 4

☐ Business No. Persons

☐ Other No. Employees

☐ Slab ☑ Crawl Space

☐ Basement w/plumbing ☐ Basement w/o plumbing


Water Supply: ☑ Private WELL ☐ Public ☐ Community

Comments / Conditions

KEEP GARAGE FOUNDATION MINIMUM 5 FEET FROM SEPTIC DRAINLINES.

INITIAL SITE SKETCH

AS BUILT SKETCH

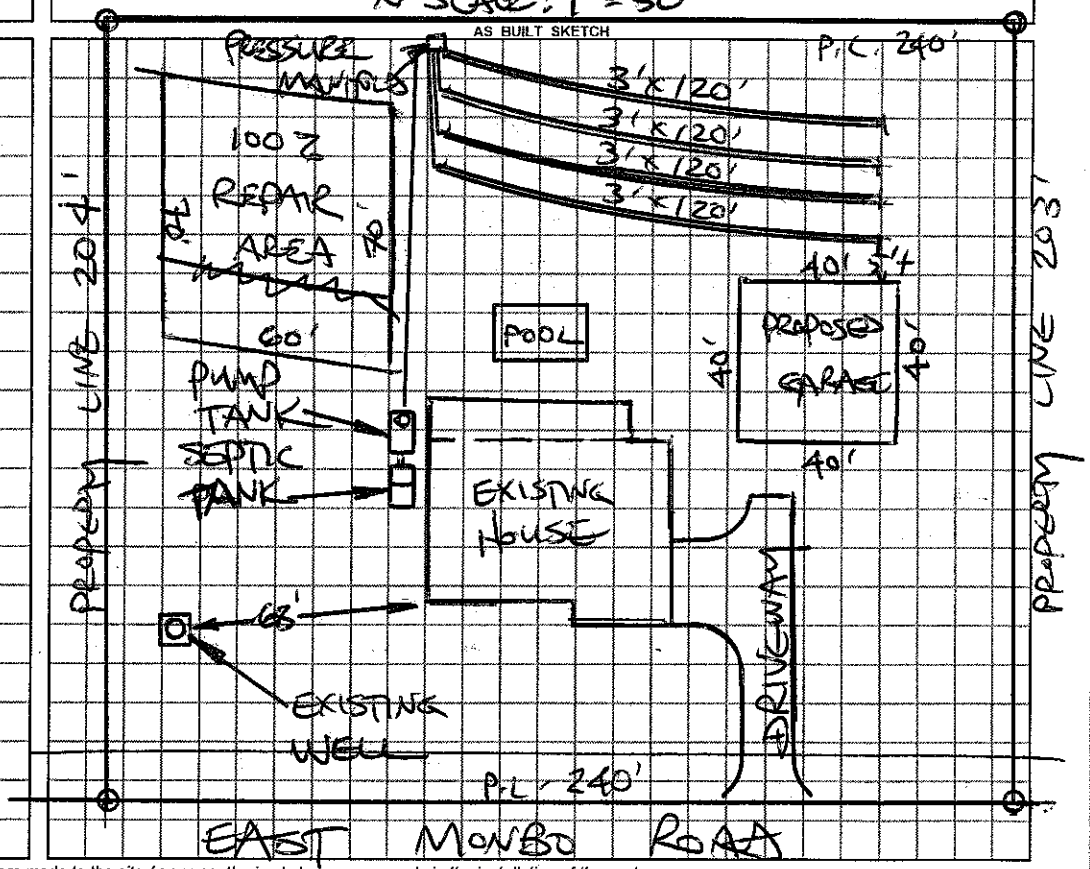

Permit can be suspended or revoked if any false information is supplied toward securing the permit / any unauthorized changes are made to the site / any unauthorized changes are made in the installation of the system.

☐ ***IMPROVEMENT PERMIT*** *with plat valid without expiration.* ☐ ***IMPROVEMENT PERMIT*** *with plat valid without expiration.* *site plan valid 60 mo.* ☐ ***AUTHORIZATION TO CONSTRUCT*** valid for period equal to IMPROVEMENT PERMIT--not to exceed 60 mo.

Owner / Applicant Signature: Date 4-17-12 Installed by:

IMPROVEMENT PERMIT by: REHS Date OPERATION PERMIT by: REHS Date

AUTHORIZATION TO CONSTRUCT by: REHS Date Existing System Inspected by: STEVE HEDRICK REHS Date 4-17-12

YOU SHOULD CONTACT A LOCATOR SERVICE PRIOR TO ANY EXCAVATION

White Copy – Environmental Health YELLOW COPY (Final) Owner / Applicant PINK COPY (Initial) Owner / Applicant