See attached permit #165420 for (C) pool addition 3/19/11.

IREDELL COUNTY HEALTH DEPARTMENT

STATESVILLE 704-878-5305 MOORESVILLE 704-664-5281

IMPROVEMENT PERMIT / AUTHORIZATION TO CONSTRUCT / OPERATION PERMIT / EXISTING SYSTEM INSPECTION

PERMIT# 135066 PIN# ~~4720490345~~ 4720490239 DATE 5-9-06

OWNER OR APPLICANT Pinecrest Land Developers PHONE: Business 704 902 6033 Home

ADDRESS East Monbo Rd

LOCATION Off Mountain Rd turns (R) on East Monbo property on (L)

SUBDIVISION Pinecrest Estates BLOCK / SECTION LOT 3 LOT AREA 1.242 SITE CLASS. PS DESIGN FLOW 480 L.T.A.R. .25

Septic Tank: 1000 Gallons: STB 825 Date 10-11-06
Pump Tank: 1000 Gallons: PT ~~1250~~ 302 Date 10-21-06
Pump Make: Zoeller Model N152B3 Serial No.
Nitrification Field: No Fields 1 Square Feet 1920 Linear Feet 120×4(480)
No Lines 4 Trench Width 3 Max Trench Bottom Depth 36

☒ New System ☐ Repair ☐ Expansion System Type: I II (III) IV V VI
System Description: 25% Reduction Pump
Repair System Description: 25% Reduction
Maintenance Agreement Required: ☐ Yes ☒ No

☒ House/Mod. Home No. Bedrooms 4
☐ Mobile Home No. Persons
☐ Business No. Employees
☐ Other

Water Supply: ☒ Individual ☐ Public ☐ Community


Gravel Depth n/a ☐ Gravity ☒ Pressure ☐ Slab ☒ Crawl Space ☐ Basement w/plumbing ☐ Basement wo/plumbing

Comments:/Conditions: and pressure manifold


Tank location, driveway, and well location may be reversed.

Comments:/Conditions:

INITIAL SITE SKETCH

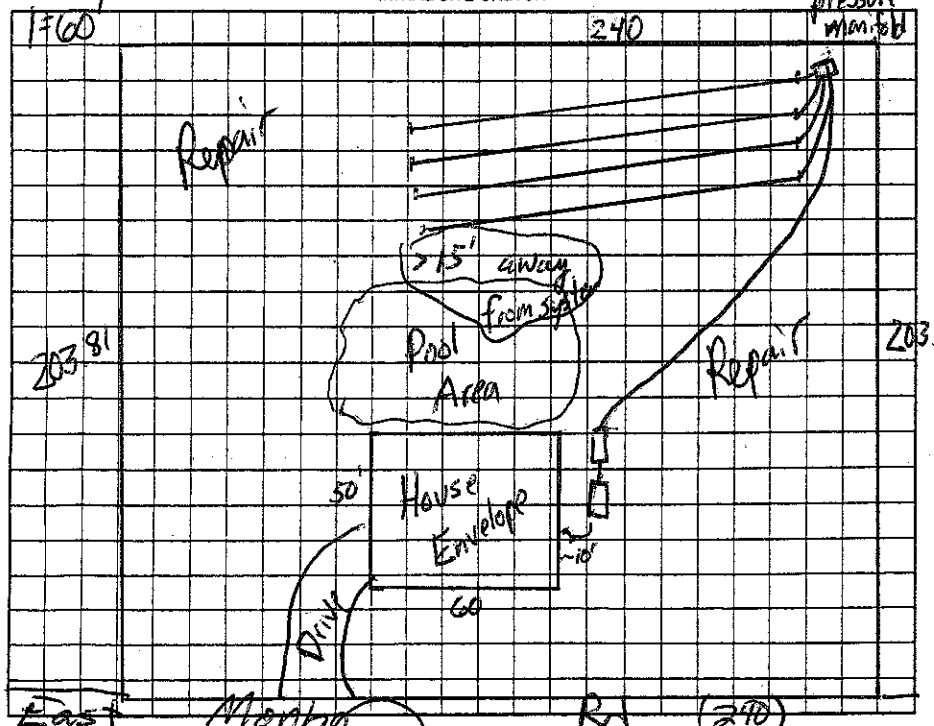

AS BUILT SKETCH

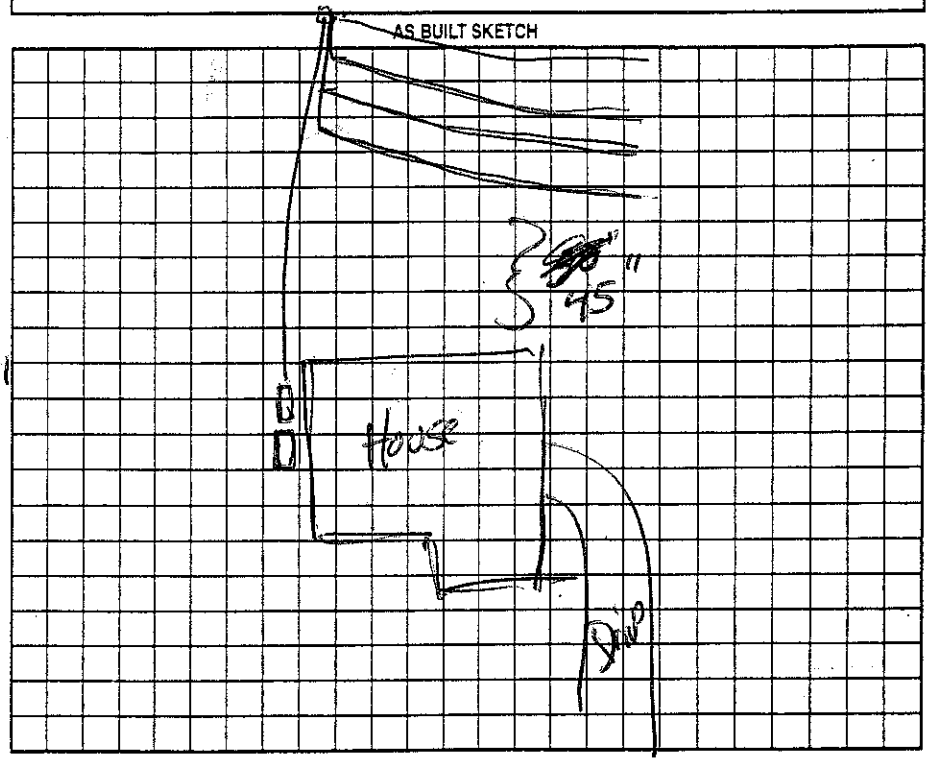

Permit can be suspended or revoked if any false information is supplied toward securing the permit/any unauthorized changes are made to the site/any unauthorized changes are made in the installation of the system. Improvement Permit with plat valid without expiration ☐ Improvement Permit with site plan valid for sixty months ☒ Authorization to Construct is valid for a period equal to that of Improvement Permit – not to exceed sixty months.

Signed: [signature] date May 10, 2006 Installed by: Rowan Septic

Improvement Permit by: [signature] date 5-9-06 Operation Permit by: [signature] R.S. date 9 May 07

Authorization to Construct by: [signature] date 5-9-06 Existing System Inspection by: date

HEALTH DEPT. COPY: WHITE OWNER COPY (FINAL): YELLOW OWNER COPY (INITIAL): PINK