IREDELL COUNTY HEALTH DEPARTMENT

STATESVILLE 704-878-5305 MOORESVILLE 704-664-5281

IMPROVEMENT PERMIT / AUTHORIZATION TO CONSTRUCT / OPERATION PERMIT / EXISTING SYSTEM INSPECTION

PERMIT # 159931 PIN # 4720-49-2309 DATE 3-1-10

OWNER or APPLICANT Pinecrest Land Developers PHONE: Business Home: 704-902-6033

OWNER or APPLICANT ADDRESS 191 Clearview Road Statesville NC 28625

LOCATION / DIRECTIONS Old Mountain Rd (R) East Monroe lot on left after Sticks Creek - before Hudspeth Ln

SUBDIVISION Pinecrest Estates BLOCK / SECTION LOT # 2 LOT AREA 1.239 DESIGN FLOW 480 L.T.A.R. .25

Septic Tank 1000 Gallons: STB 825 Date 4-2-10

Pump Tank Gallons: P T Date

Pump Make Model Serial #

Nitrification Field No Fields No Lines 5 Linear Feet 480

Trench Width 36" Max. Trench Bottom Depth 36" Gravel Depth N/A

☒ New System ☐ Repair ☐ Expansion System Type I II (III) IV V VI

System Description: 25% Gravity

Repair System Description: 50% low pres / Gravity

Maintenance Agreement Required ☐ YES ☒ NO

☒ GRAVITY ☐ PRESSURE


☒ Residence No. Bedrooms 4
☐ Business No. Persons
☐ Other No. Employees
☐ Slab ☒ Crawl Space
☐ Basement w/plumbing ☐ Basement w/o plumbing

Water Supply
☒ Private
☐ Public
☐ Community

Comments / Conditions

Comments / Conditions
* Install on contour
* Maintain all setbacks

INITIAL SITE SKETCH

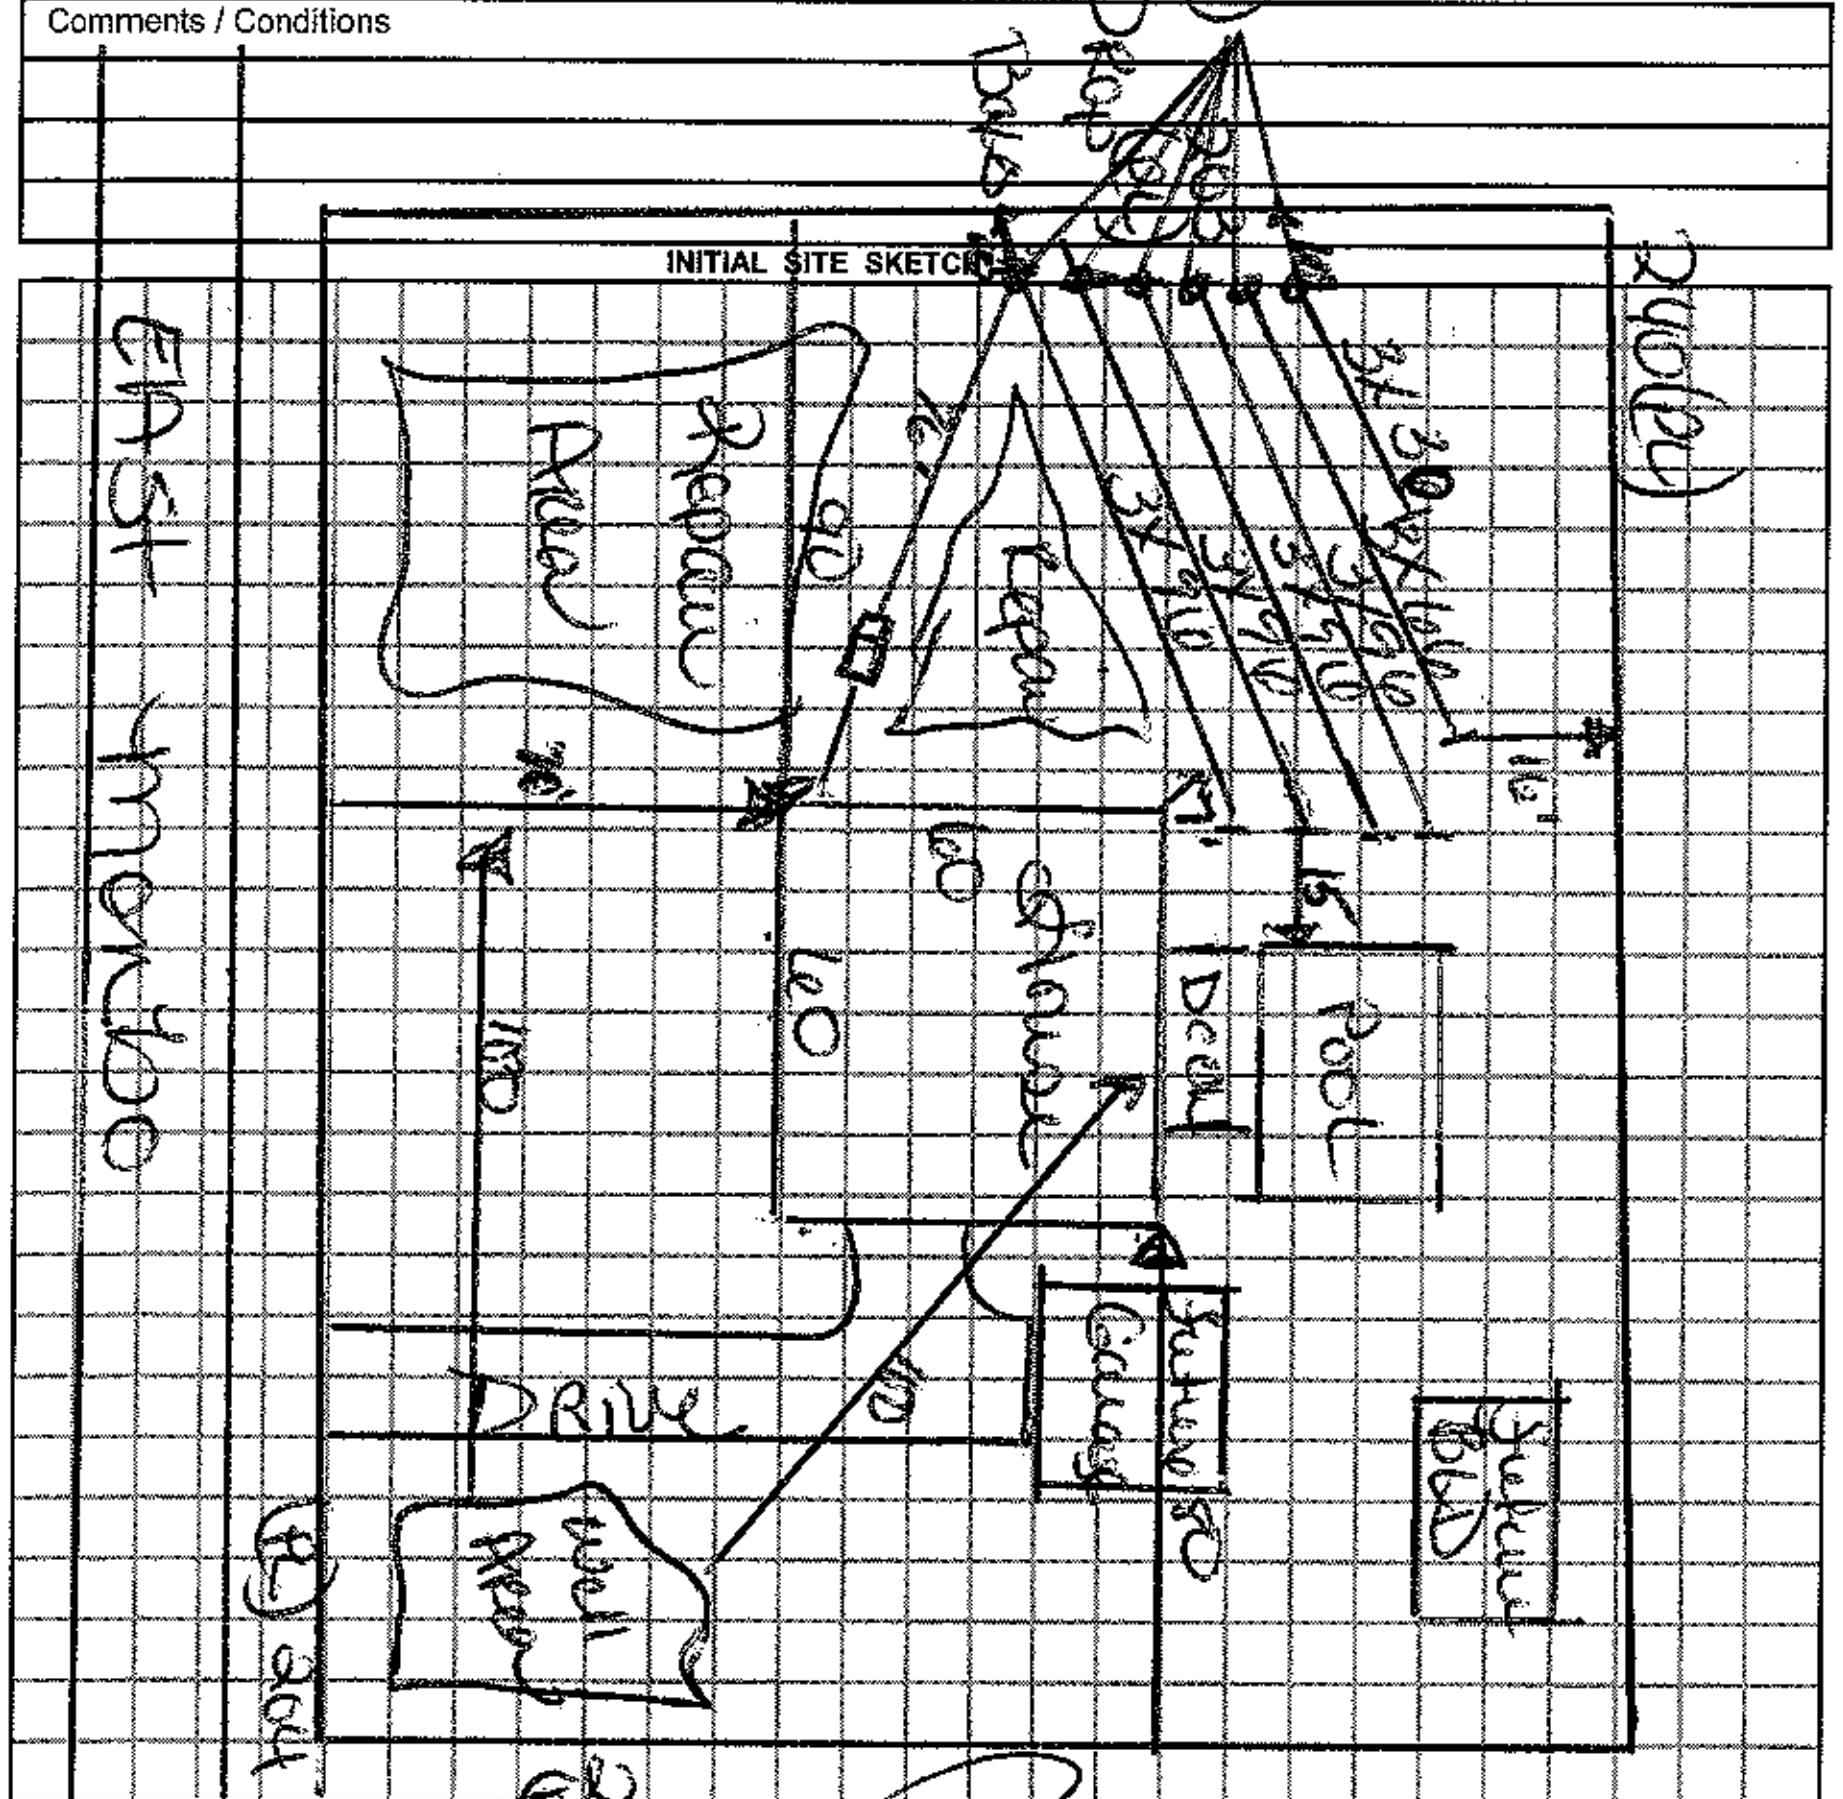

AS BUILT SKETCH

(1" = 60')

(5) 96'

Permit can be suspended or revoked if any false information is supplied toward securing the permit / any unauthorized changes are made to the site / any unauthorized changes are made in the installation of the system.

☐ *IMPROVEMENT PERMIT w / plat valid without expiration.* ☒ *IMPROVEMENT PERMIT w / site plan valid for 60 mos.* ☒ *AUTHORIZATION TO CONSTRUCT valid for period equal to IMPROVEMENT PERMIT-not to exceed 60 mo.*

Owner / Applicant Signature: [signature] Date March 2, 2010

Improvement Permit by: [signature] Date 3-1-10

Authorzation to Construct by: [signature] Date 3-1-10

Installed by: Rowan Septic

Operation Permit by: [signature] Date: 6-1-10

Existing System Inspected by: Date:

YOU SHOULD CONTACT A LOCATOR SERVICE PRIOR TO ANY EXCAVATION.

WHITE COPY Environmental Health YELLOW COPY (Final) Owner / Applicant PINK COPY (Initial) Owner / Applicant