IREDELL COUNTY HEALTH DEPARTMENT

STATESVILLE 704-878-5305 MOORESVILLE 704-664-5281

IMPROVEMENT PERMIT / AUTHORIZATION TO CONSTRUCT / OPERATION PERMIT / EXISTING SYSTEM INSPECTION

DATE 9/16/98

PERMIT# 074571 PIN# 4639734550 PT

OWNER OR CONTRACTOR Crescent Resources PHONE: Business 663-6905 Home

ADDRESS PO Box 1003 Charlotte NC 28201

LOCATION State Park Rd TL Wildlife TR SIERRA TL Deer Run TR Eagle Chase

SUBDIVISION Wildlife Bay BLOCK / SECTION 1 LOT 58 LOT AREA 32,003 SITE CLASS PS DESIGN FLOW 480gpd L.T.A.R. .3

Septic Tank: 1000 Gallons: STB 7-18-99 Date 7-9-4

Pump Tank: 1000 Gallons; PT 9-22-99 Date 27

Pump Make: Hydromatic Model SK 750 M1 Serial No.

Nitrification Field: No Fields 1 Square Feet 1200' Linear Feet 400'

No Lines 6 at 67' Trench Width 36" Max Trench Bottom Depth 36" Gravel Depth N/A

X New System [ ] Repair System Type: I, II, III, IV, V, VI

System Description: Pump-PM - 25% Reduction

Repair System Description: Pump-Panel Blk

Maintenance Agreement Required: [ ] Yes X No

X House/Mod. Home [ ] Mobile Home [ ] Business [ ] Other

No. Bedrooms 4 No. Bathrooms 4 No. Employees


[ ] Slab [ ] Crawl Space X Basement w/plumbing [ ] Basement wo/plumbing

Water Supply: [ ] Individual [ ] Public X Community


Comments:/Conditions: Keep Septic System at least 10' From PL & 50' from Lake.

Comments:/Conditions: Partial
11-1 Tanks Set & OK
5-4 Lines Installed
6 of 21 Pressure Set - Alarm OK - May 4 2000

INITIAL SITE SKETCH Scale 1:50

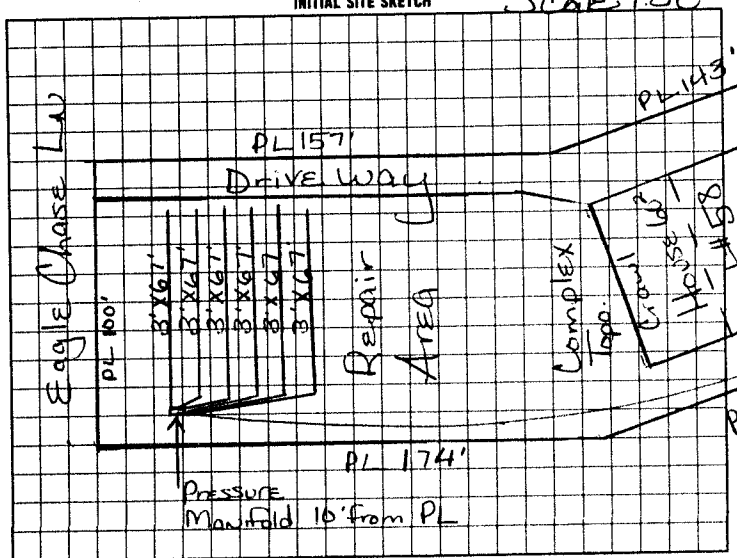

AS BUILT SKETCH

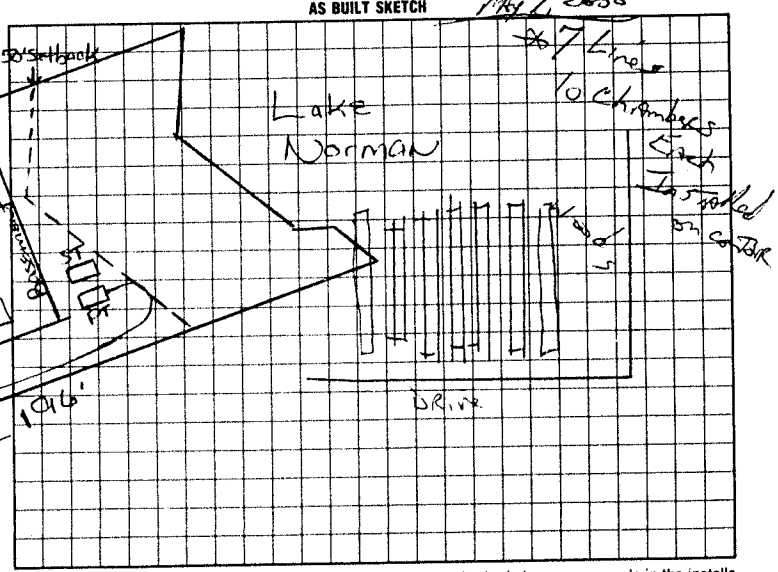

I understand that this permit can be suspended or revoked if any false information is supplied toward securing the permit/any unauthorized changes are made to the site/any unauthorized changes are made in the installation of the system. Improvement Permit with plat valid without expiration. Improvement Permit with site plan valid for sixty months. Authorization to Construct is valid for a period equal to that of Improvement Permit – not to exceed sixty months.

Signed: Paul G. Pruitt date 10-5-98

Improvement Permit by: Maria H. Dolan, RS date 9/16/98

Authorization to Construct by: R.C. Moore date 3-25-99

Installed by: James Huddlor

Operation Permit by: Jc Litter date June 21 2000

Existing System Inspection by: date

HEALTH DEPT COPY: WHITE INSPECTION COPY (FINAL): GREEN OWNER COPY (FINAL): YELLOW INSPECTION COPY (INITIAL): PINK OWNER COPY (INITIAL): GOLD