9-30- 10:00

# IREDELL COUNTY HEALTH DEPARTMENT

STATESVILLE 704-878-5305 MOORESVILLE 704-664-5281

## IMPROVEMENT PERMIT / AUTHORIZATION TO CONSTRUCT / OPERATION PERMIT / EXISTING SYSTEM INSPECTION

PERMIT# 74573 PIN# 4639734550 DATE 4-16-99

OWNER OR CONTRACTOR William J. Gaughan PHONE: Business Home 704 543 0993

ADDRESS 10628 Old Waysite Rd Charlotte N.C.

LOCATION State Pk Rd TL Wildlife TR Sierra TL Deer Run TR Eagle Chase on Rt.

SUBDIVISION Wildlife Bay BLOCK / SECTION LOT 60+61 LOT AREA 1 3/4 acres SITE CLASS PS DESIGN FLOW 360 L.T.A.R. .3

Septic Tank: 1000 Gallons; STB 794 Date 12 13 99

Pump Tank: 1000 Gallons; PT 27 Dellinger Date 3 5 00

Pump Make: Myers Model M.E.50511 Serial No. Date 7-9 Y2K

Nitrification Field: No Fields 1 Square Feet 400 Linear Feet 200

No Lines 4 Trench Width 24" Max Trench Bottom Depth 36" Gravel Depth N/A

☑ New System ☐ Repair System Type: I, II, III, IV, V, VI

System Description: Pump to LPP panels

Repair System Description:

Maintenance Agreement Required: ☐ Yes ☐ No

☑ House/Mod. Home No. Bedrooms 3

☐ Mobile Home No. Bathrooms 3

☐ Business No. Employees

☐ Other

☐ Slab ☐ Crawl Space ☐ Basement w/plumbing ☐ Basement wo/plumbing

Water Supply: ☐ Individual ☐ Public ☑ Community

Comments:/Conditions:


Replaces permit issued on 60 + 61 10-19-98

See Attached sheets for Pump Tank + Drain line setup

Comments:/Conditions:

A certified Sub-Surface operator must be on Contract before operations permit can be issued

INITIAL SITE SKETCH

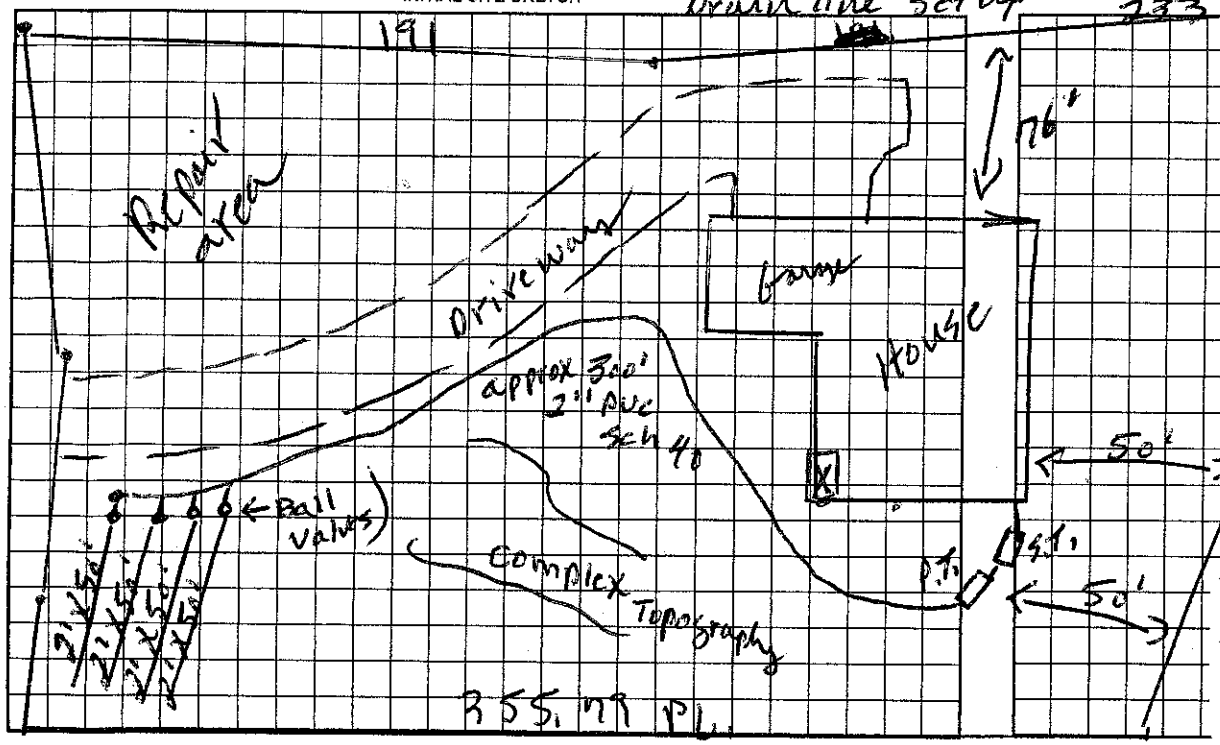


AS BUILT SKETCH

Apr 12: Lines installed As shown

Apr 12: Septic & Pump Tank installed As designed

June 21- Pressure set Alarm ck Elect. ck

The proposed Closet expansion addition does not appear to impact the existing septic system.

**NOTE:

R.S.

Date: 13 JAN 2009

ICHD-Environmental Health Division

Permit can be suspended or revoked if any false information is supplied toward securing the permit/any unauthorized changes are made to the site/any unauthorized changes are made in the installation of the system. Improvement Permit with plat valid without expiration. Improvement Permit with site plan valid for sixty months. Authorization to Construct is valid for a period equal to that of Improvement Permit – not to exceed sixty months.

Signed: William J Gaughan date Installed by: Bob Mayhew

Improvement Permit by: P. C. Moore date 4-16-99 Operation Permit by: JC Potter date June 21 2000

Authorization to Construct by: P. C. Moore date 4-16-99 Existing System Inspection by: date

HEALTH DEPT. COPY: WHITE OWNER COPY (FINAL): YELLOW OWNER COPY (INITIAL): PINK