9-30- 10:00

IREDELL COUNTY HEALTH DEPARTMENT

STATESVILLE 704-878-5305 MOORESVILLE 704-664-5281

IMPROVEMENT PERMIT / AUTHORIZATION TO CONSTRUCT / OPERATION PERMIT / EXISTING SYSTEM INSPECTION

PERMIT# 74573 PIN# 4639734550 4720-50-3179 DATE 4-16-99

OWNER OR CONTRACTOR William J. Gaughan PHONE: Business _____ Home 704 543 0993

ADDRESS 10628 Old Wayside Rd Charlotte N.C.

LOCATION State Pk Rd TL Wildlife TR Sierra TL Deer Run TR Eagle chase on Rt.

SUBDIVISION Wildlife Bay BLOCK / SECTION _____ LOT 60+61 LOT AREA 3/4 acre SITE CLASS. P5 DESIGN FLOW 360 L.T.A.R. .3

Septic Tank: 1000 Gallons; STB 794 Date 12 13 99

Pump Tank: 1000 Gallons; PT 27 Dellinger Date 3 5 00

Pump Make: Myers Model ME50511 Serial No. Date 7-9 1/2 11

Nitrification Field; No Fields 1 Square Feet 400 Linear Feet 200

No Lines 4 Trench Width 24" Max Trench Bottom Depth 36" Gravel Depth N/A

☑ New System ☐ Repair System Type: I, II, III, IV, V, VI

System Description: Pump to LPP panels

Repair System Description: " " " "

Maintenance Agreement Required: ☐ Yes ☐ No

☑ House/Mod. Home No. Bedrooms 3

☐ Mobile Home No. Bathrooms 3

☐ Business No. Employees _____

☐ Other _____

☐ Slab ☐ Crawl Space ☐ Basement w/plumbing ☐ Basement wo/plumbing

Water Supply: ☐ Individual ☐ Public ☑ Community


Comments:/Conditions: Replaces permit issued on 60 + 61 10-19-98

See Attached sheets for Pump Tank + Drain line setup


Comments:/Conditions:

A certified Sub-surface operator must be in Contract before operations permit can be issued

INITIAL SITE SKETCH

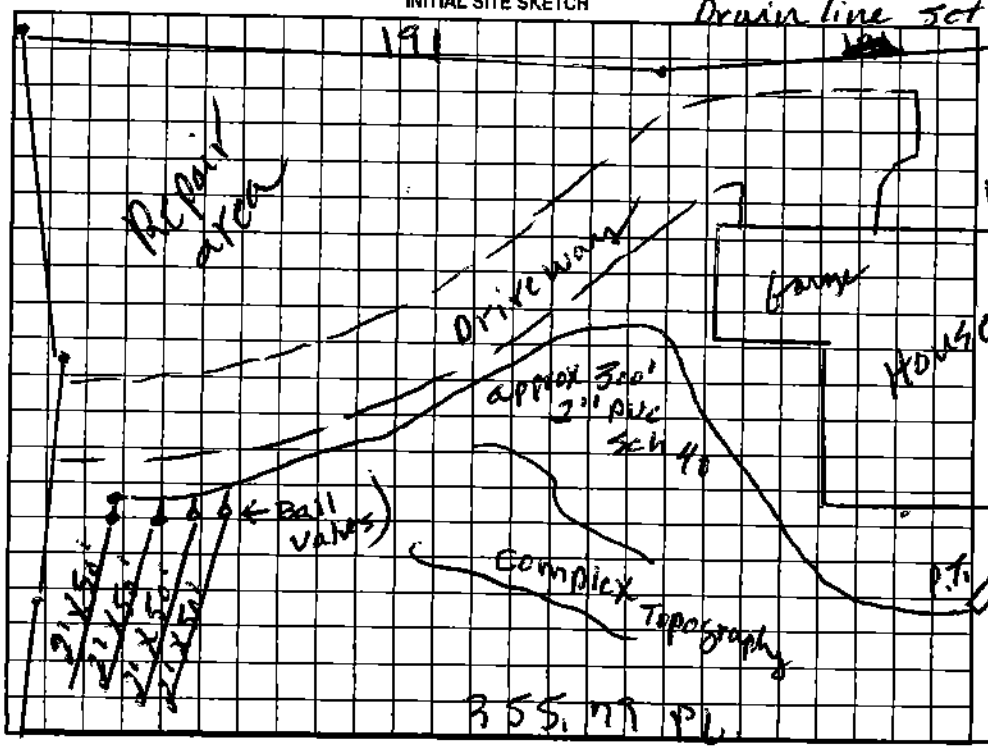

AS BUILT SKETCH

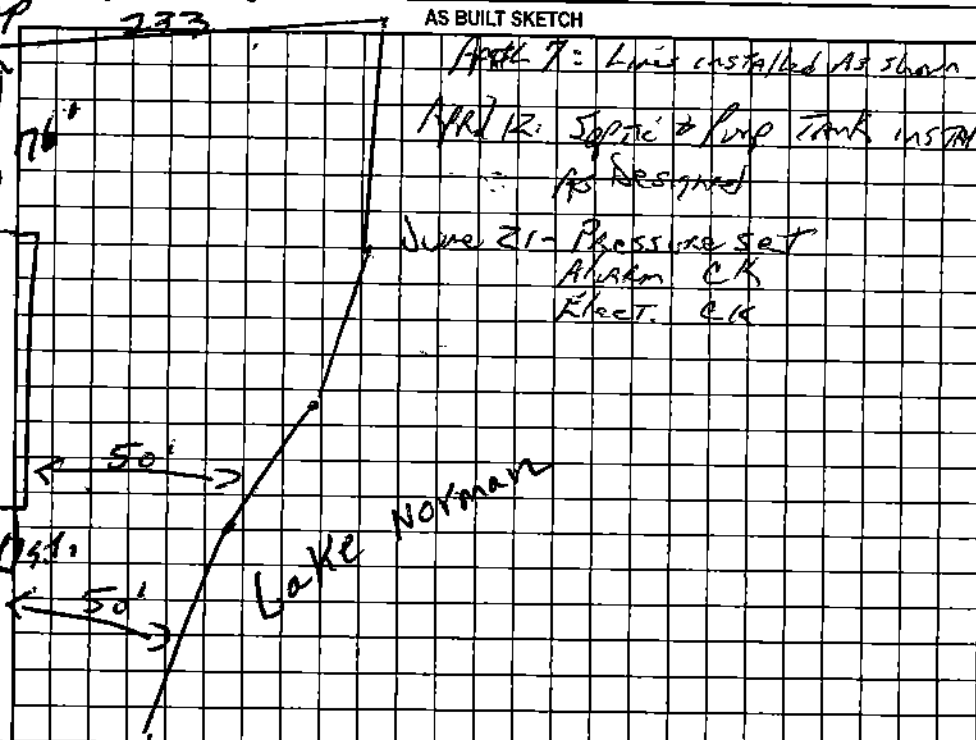



June 21- Pressure set Alarm CK Elect. CK

Permit can be suspended or revoked if any false information is supplied toward securing the permit/any unauthorized changes are made to the site/any unauthorized changes are made in the installation of the system. Improvement Permit with plat valid without expiration. Improvement Permit with site plan valid for sixty months. Authorization to Construct is valid for a period equal to that of Improvement Permit – not to exceed sixty months.

Signed: William J Gaughan date _____ Installed by: Bob Mayhew

Improvement Permit by: P. C. Moore date 4-16-99 Operation Permit by: Joe Potter date June 21-2000

Authorization to Construct by: P. C. Moore date 4-16-99 Existing System Inspection by: _____ date _____

HEALTH DEPT. COPY: WHITE OWNER COPY (FINAL): YELLOW OWNER COPY (INITIAL): PINK