IREDELL COUNTY HEALTH DEPARTMENT

STATESVILLE 704-878-5305 MOORESVILLE 704-664-5281

IMPROVEMENT PERMIT / AUTHORIZATION TO CONSTRUCT / OPERATION PERMIT / EXISTING SYSTEM INSPECTION

PERMIT# 74576 PIN# 4639734550 4720-50-5034 DATE 1-12-99

OWNER OR CONTRACTOR Pete + Sherry Smith PHONE: Business 892-1509 Home

ADDRESS 191 Bridgeport Dr. Mooresville, N.C.

LOCATION State Pk Rd TL Wildlife Rd TR Sierra TL Deer Run TR Eagle Chase 5th lot on rt

SUBDIVISION Wildlife Bay BLOCK / SECTION 1 LOT 62 LOT AREA 35665 SF SITE CLASS. PS DESIGN FLOW 480 L.T.A.R. .3

Septic Tank: 1000 Gallons; STB 317 Date 4-26-99

Pump Tank: 1000 Gallons; PT [redacted] Date 6-30-99

Pump Make: Hydromatic Model SHEF 50 Serial No.

Nitrification Field: No Fields 1 Square Feet 900 Linear Feet 300

No Lines 5 Trench Width 36" Max Trench Bottom Depth 36" Gravel Depth N/A

☑ New System ☐ Repair System Type: I, II, III, IV, V, VI

System Description: Pressure Dosed panel

Repair System Description: " " "

Maintenance Agreement Required ☑ Yes ☐ No

☑ House/Mod. Home No. Bedrooms 4

☐ Mobile Home No. Bathrooms 4

☐ Business No. Employees

☑ Other


☐ Slab ☐ Crawl Space ☑ Basement w/plumbing ☐ Basement wo/plumbing

Water Supply: ☐ Individual ☐ Public ☑ Community


Comments:/Conditions: See Attached Sheets for P.I. + Pressure line Setup. Also Before operations permit can be issued certified operator must be on contract.

Comments:/Conditions: Apr/14: Bottom 3 Lines installed as shown Inspected Top 2 Lines Pressure Check + checked + set valves Jcm 4-27-00

INITIAL SITE SKETCH

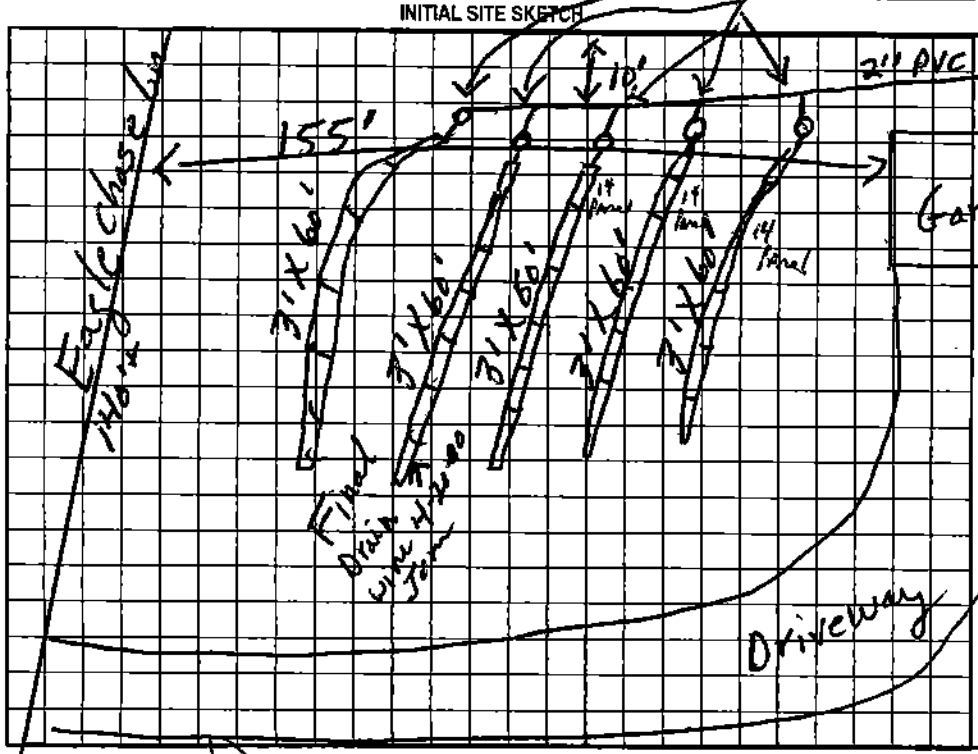

AS BUILT SKETCH

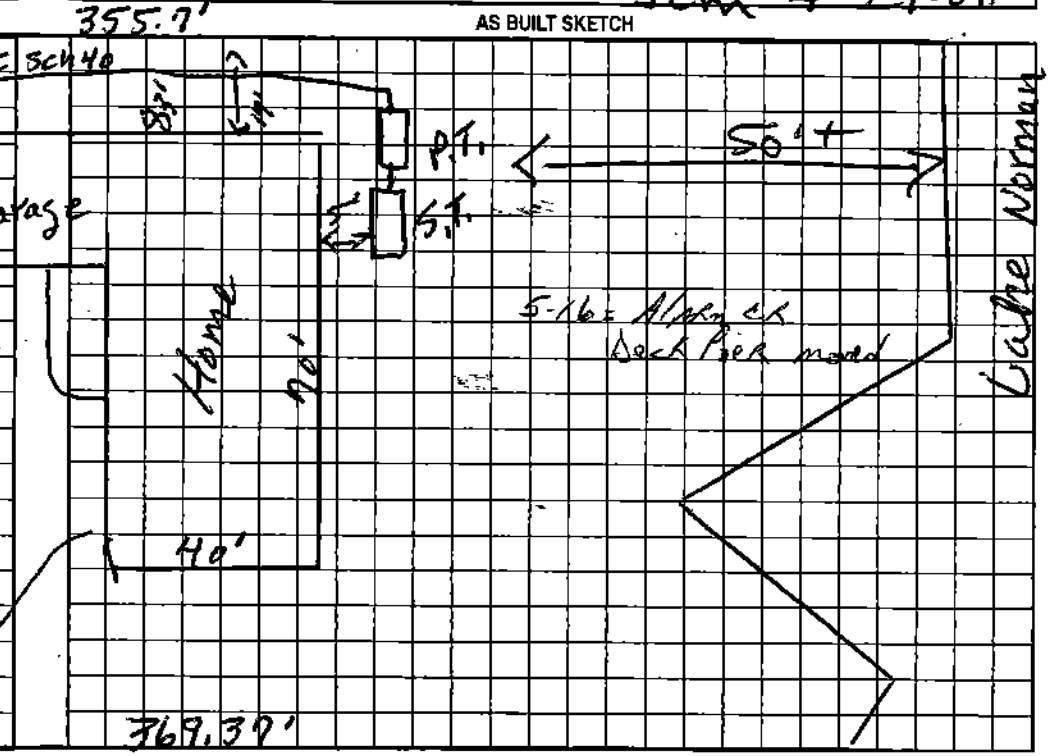

Permit can be suspended or revoked if any false information is supplied toward securing the permit/any unauthorized changes are made to the site/any unauthorized changes are made in the installation of the system. Improvement Permit with plat valid without expiration. Improvement Permit with site plan valid for sixty months. Authorization to Construct is valid for a period equal to that of Improvement Permit – not to exceed sixty months.

Signed: [redacted] date 1-15-99 Installed by: C + W Grading May 16 2000

Improvement Permit by: [redacted] date 1-12-99 Operation Permit by: [redacted] date May 16 2000

Authorization to Construct by: R.C. Moore date 1-12-99 Existing System Inspection by: date

HEALTH DEPT. COPY: WHITE OWNER COPY (FINAL): YELLOW OWNER COPY (INITIAL): PINK