CI

4.5

IREDELL COUNTY HEALTH DEPARTMENT

STATESVILLE 704-878-5305 MOORESVILLE 704-664-5281

IMPROVEMENT PERMIT / AUTHORIZATION TO CONSTRUCT / OPERATION PERMIT / EXISTING SYSTEM INSPECTION

PERMIT# 137341 PIN# 4720-50-6955 Bill Ray's cell 704-309-5073 DATE 8-25-06

OWNER OR APPLICANT ABJ CONSTRUCTION INC PHONE: Business 704-664-4353 Home

ADDRESS 1184 BRADLEY SCHOOL RD MOORESVILLE NC 28115

LOCATION PERTH RD (E) STATE PARK (L) Wildlife (R) Silver Woods (R) MAPLEVIEW (L) DEAD END AT END

SUBDIVISION Wildlife Bay BLOCK / SECTION II LOT 89/89A LOT AREA 0.706 SITE CLASS. 1S DESIGN FLOW 480 L.T.A.R. .3

Septic Tank: 1000 Gallons: STB 312 Date 6-13-06
Pump Tank: 1000 Gallons: PT 27 Date 7-25-06
Pump Make: Goulds Model WOBD 12HU Serial No. K056698T
Nitrification Field: No Fields 1 Square Feet ED=1600' Linear Feet 400'
No Lines 4X100' Trench Width 36" Max Trench Bottom Depth 36"

☒ New System ☐ Repair ☐ Expansion System Type: I II (III) IV V VI
System Description: PUMP 25% REDUCTION
Repair System Description: LD 25% REDUCT 50%
Maintenance Agreement Required: ☐ Yes ☒ No

☒ House/Mod. Home ☐ Mobile Home ☐ Business ☐ Other
No. Bedrooms 4 No. Persons 8 No. Employees

Water Supply: ☐ Individual ☒ Public ☒ Community

Gravel Depth N/A ☐ Gravity ☒ Pressure ☐ Slab ☐ Crawl Space ☒ Basement w/plumbing ☐ Basement wo/plumbing

Comments:/Conditions: (1) INSTALL LINES ON CONTOURS (2) MAINTAIN SETBACKS. THIS INCLUDES ALL DRAINS. (3) Supply Lines Installed BY ROADS WERE BUILT.

Comments:/Conditions: POLYLOK Filter & MARKER RISERS TANKS INSTALLED BY HOUSE WAS BUILT TANKS 76' FROM NEW 760' MARK

INITIAL SITE SKETCH

SEE ATTACHED PLAN FOR SYSTEM DESIGN. DRAWN BY A. LORNE COOK R.S.

AS BUILT SKETCH

TANKS SWITCHED: NEED PERMISSION FROM BUILDER
LINES INSTALLED DURING WET SOIL CONDITIONS

CALLED ABJ CONST & FJ DRAIN RESET FLAGS ON WEEK OF MARCH 17TH. CALLED & LEFT MESSAGE TO LORNE COOK AND LOU FIDANZA

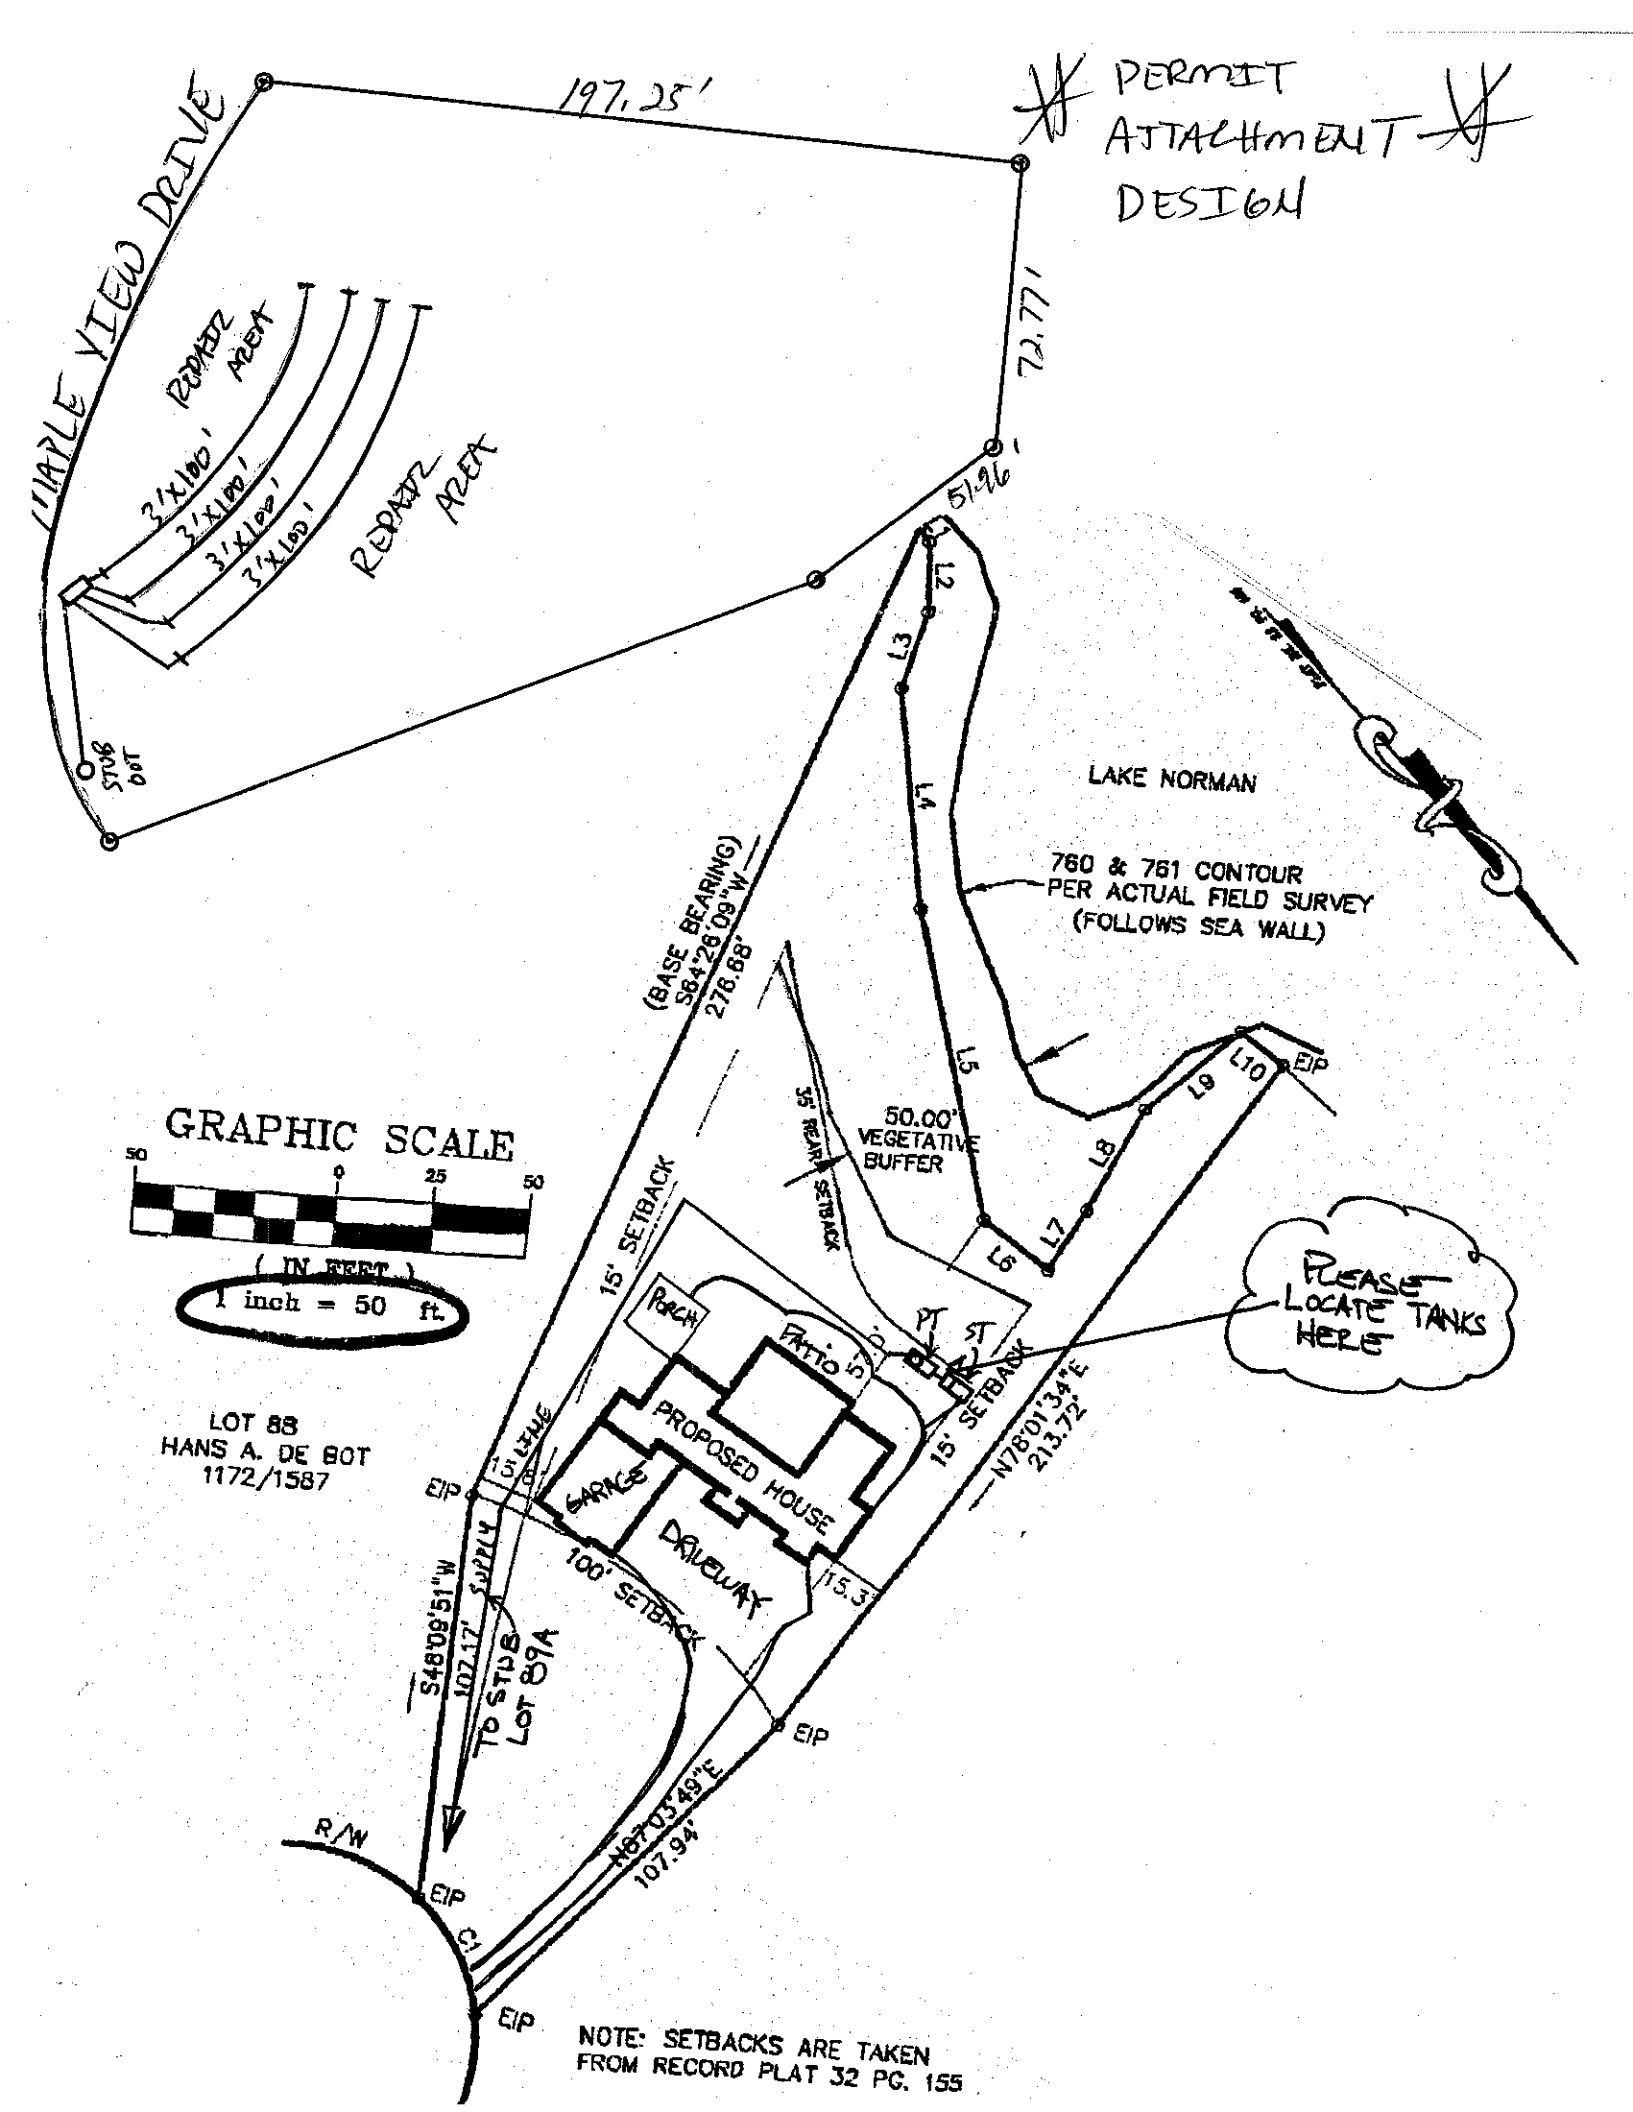
Permit can be suspended or revoked if any false information is supplied toward securing the permit/any unauthorized changes are made to the site/any unauthorized changes are made in the installation of the system. Improvement Permit with plat valid without expiration ☐ Improvement Permit with site plan valid for sixty months ☒ Authorization to Construct is valid for a period equal to that of Improvement Permit – not to exceed sixty months.

Signed: ABJ By [signature] date 8-25-06 Installed by: FJ DRAIN

Improvement Permit by: [signature] date 8-25-06 Operation Permit by: [signature] date 10-22-07

Authorization to Construct by: [signature] date 8-25-06 Existing System Inspection by: date

HEALTH DEPT. COPY: WHITE OWNER COPY (FINAL): YELLOW OWNER COPY (INITIAL): PINK


PERMIT ATTACHMENT
DESIGN
MAPLE VIEW DRIVE
197.25'
72.77'
51.96'
REMOVE AREA
3'x100'
3'x100'
3'x100'
3'x100'
REMOVE AREA
STUB OUT
LAKE NORMAN
760 & 761 CONTOUR
PER ACTUAL FIELD SURVEY
(FOLLOWS SEA WALL)
(BASE BEARING)
S64°26'09"W
276.68'
L2
L3
L4
L5
L6
L7
L8
L9
L10
EIP
50.00'
VEGETATIVE
BUFFER
35' REAR SETBACK
15' SETBACK
GRAPHIC SCALE
50 0 25 50
(IN FEET)
1 inch = 50 ft.
PORCH
PATIO
PT
ST
PROPOSED HOUSE
GARAGE
DRIVEWAY
15' SETBACK
N78°01'34"E
213.72'
PLEASE LOCATE TANKS HERE
LOT 88
HANS A. DE BOT
1172/1587
EIP
UTILITIES
SUPPLY
S48°09'51"W
107.17'
TO STUB
LOT 89A
100' SETBACK
15.3'
EIP
R/W
EIP
C1
EIP
N67°03'49"E
107.94'
NOTE: SETBACKS ARE TAKEN
FROM RECORD PLAT 32 PG. 155