IREDELL COUNTY HEALTH DEPARTMENT

STATESVILLE 704-878-5305 MOORESVILLE 704-664-5281

IMPROVEMENT PERMIT / AUTHORIZATION TO CONSTRUCT / OPERATION PERMIT / EXISTING SYSTEM INSPECTION

pg 9/30

PERMIT# 1252420 PIN# 4720509943 DATE 7-20-05

OWNER OR CONTRACTOR Pruett Homes PHONE: Business 704-664-1808 Home

ADDRESS 578 Normandy RD Mooresville NC 28117

LOCATION Shelor Park RD (R) wild Life bay (R) Sierra wood (R) Deer Run 4th lot left

SUBDIVISION Wild Life bay BLOCK / SECTION LOT 72 LOT AREA 19,500 SITE CLASS. 45 DESIGN FLOW 450 L.T.A.R. .43

Septic Tank: 1000 Gallons; STB 1017 Date 8-1-05

Pump Tank: 1000 Gallons; P.T. 17 Date 1-1-06

Pump Make: Gould Model WE1012H0 Serial No.

Nitrification Field: No Fields ___ Square Feet 1600 Linear Feet 400

No Lines 7 Trench Width 36" Max Trench Bottom Depth 36" Gravel Depth

☐ New System ☐ Repair System Type: I, II, III, IV, V, VI

System Description: 25% pump PM

Repair System Description: ~~25~~ 50% pump PM

Maintenance Agreement Required: ☐ Yes ☐ No

☑ House/Mod. Home No. Bedrooms 4

☐ Mobile Home No. Bathrooms ___

☐ Business No. Employees ___

☐ Other


☐ Slab ☐ Crawl Space ☑ Basement w/plumbing ☐ Basement wo/plumbing

Water Supply: ☑ Individual ☐ Public ☐ Community


Comments:/Conditions:

Comments:/Conditions:

INITIAL SITE SKETCH

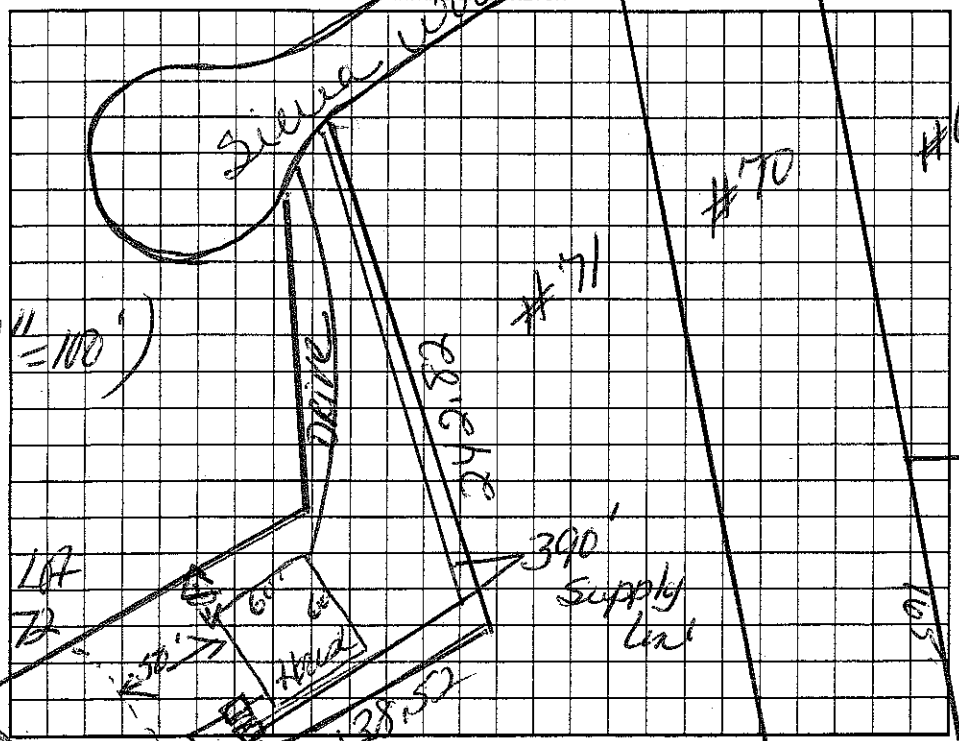

AS BUILT SKETCH

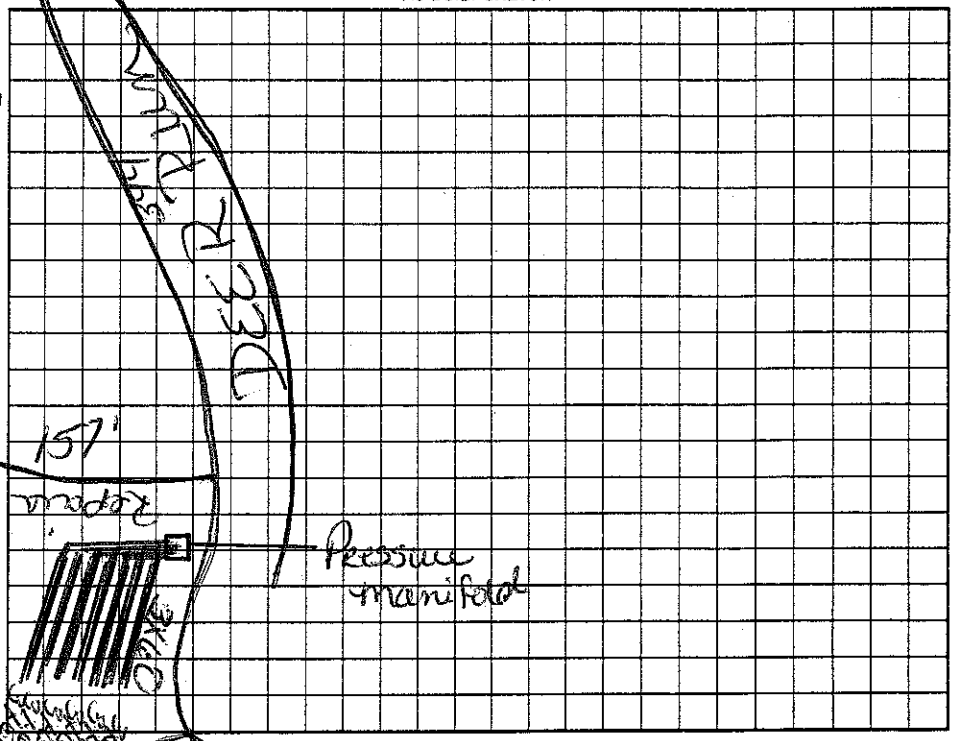

Permit can be suspended or revoked if any false information is supplied toward securing the permit/any unauthorized changes are made to the site/any unauthorized changes are made in the installation of the system. Improvement Permit with plat valid without expiration. Improvement Permit with site plan valid for sixty months. Authorization to Construct is valid for a period equal to that of Improvement Permit – not to exceed sixty months.

Signed: ___ date 8-29-05 Installed by: C Graham

Improvement Permit by: Lucy Cook date 7-20-05 Operation Permit by: Lucy Cook date 8-8-06

Authorization to Construct by: Lucy Cook date 7-20-05 Existing System Inspection by: ___ date ___

HEALTH DEPT. COPY: WHITE OWNER COPY (FINAL): YELLOW OWNER COPY (INITIAL): PINK