IREDELL COUNTY HEALTH DEPARTMENT

STATESVILLE 704-878-5305 CI MOORESVILLE 704-664-5281

IMPROVEMENT PERMIT / AUTHORIZATION TO CONSTRUCT / OPERATION PERMIT / EXISTING SYSTEM INSPECTION

PERMIT# ~~074856~~ 110949 PIN# ~~4639-73-4550-PF~~ 472050 9598 DATE 11/3/98

OWNER OR CONTRACTOR Crescent Resources PHONE: Business 663-6905 Home

ADDRESS P.O. Box 1003 Charlotte, NC 28201

LOCATION State Park TL Wildlife TR Sierra Woods 4th on Right after Deer Run

SUBDIVISION Wildlife Bay BLOCK / SECTION I LOT 76/76A LOT AREA 33,238 sq ft SITE CLASS. DESIGN FLOW 480gpd L.T.A.R. .3

Septic Tank: 1000 Gallons; STB 1007 Date 10/08/02
Pump Tank: 1000 Gallons; PT 274 Date 10/08/01
Pump Make: ZOLLER Model E-165-C Serial No. 1.0 H.P.
Nitrification Field: No Fields 1 Square Feet 1200' Linear Feet 400'
No Lines 5 at 80' Trench Width 36" Max Trench Bottom Depth 36" Gravel Depth N/A

☒ New System ☐ Repair System Type: I, II, III, IV, V, VI
System Description: Pump-PM-25% Reduction OFFSITE
Repair System Description: Pump-Panel Block
Maintenance Agreement Required: ☐ Yes ☒ No

☒ House/Mod. Home No. Bedrooms 4
☐ Mobile Home No. Bathrooms 4
☐ Business No. Employees
☐ Other
☐ Slab ☐ Crawl Space ☒ Basement w/plumbing ☐ Basement wo/plumbing


Water Supply: ☐ Individual ☐ Public ☒ Community

Comments:/Conditions: ☒ Drainfield Area located Offsite on Lot #76A. Keep Septic System at least 10' from PL & 50' from lake.


Comments:/Conditions: -65 Bio-diffuser chamber installed, liners PM are okay; 6/19/02 pressure check + Electrical Alarm Okay 7/18/03 lyk

INITIAL SITE SKETCH

Scale 1:100

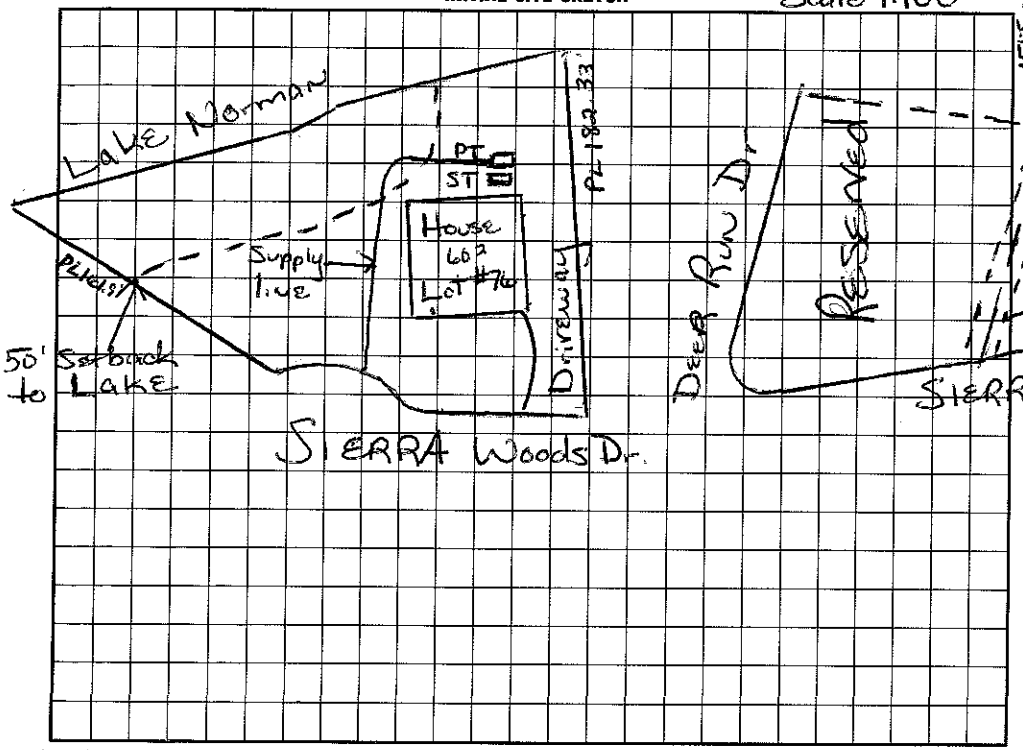

AS BUILT SKETCH

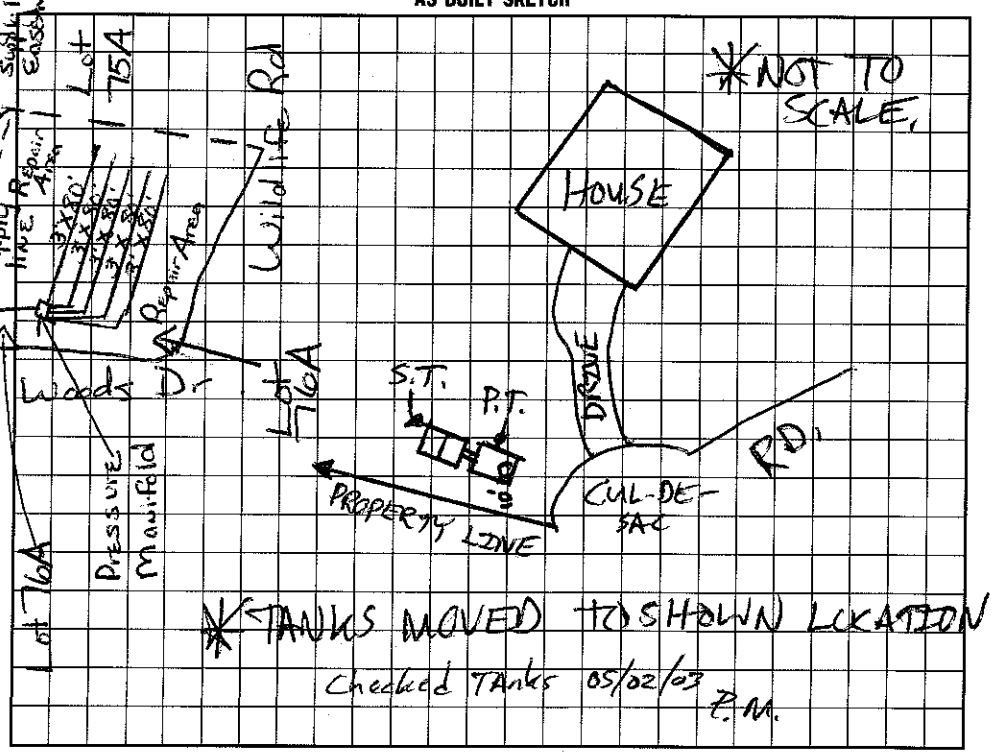

I understand that this permit can be suspended or revoked if any false information is supplied toward securing the permit/any unauthorized changes are made to the site/any unauthorized changes are made in the installation of the system. Improvement Permit with plat valid without expiration. Improvement Permit with site plan valid for sixty months. Authorization to Construct is valid for a period equal to that of Improvement Permit – not to exceed sixty months.

Signed: Paul B. Pinyan date 11-9-98

Improvement Permit by: Maria H.H. Dotson R.S. date 11/3/98

Authorization to Construct by: William O. Johnson date 6/19/02

Installed by: Wayne Clontz

Operation Permit by: William O. Johnson date 7/18/03

Existing System Inspection by: date

HEALTH DEPT. COPY: WHITE INSPECTION COPY (FINAL): GREEN OWNER COPY (FINAL): YELLOW INSPECTION COPY (INITIAL): PINK OWNER COPY (INITIAL): GOLD