PEGGY SPIVEY

This permit Voids Previously issued permit 5/16

IREDELL COUNTY HEALTH DEPARTMENT

STATESVILLE 704-878-5305 or MOORESVILLE 704-664-5281

IMPROVEMENT PERMIT / AUTHORIZATION TO CONSTRUCT / OPERATION PERMIT / EXISTING SYSTEM INSPECTIO

DATE 4/5/0

PERMIT# 07710/0 PIN# 4639734550 4720-50-9852

OWNER OR CONTRACTOR Welbon Properties Inc. / Covenant Reformed PHONE: Business (704) 896-9886 Home Cell (704) 202-9822

ADDRESS 18116 W. Catawba Ave Suite 310, Cornelius, N.C. 28031

LOCATION State Park Rd (L) Wildlife, (R) Sierra Woods, (R) Mode View, (L) Deer Cove Lane

SUBDIVISION Wildlife Bay BLOCK / SECTION II LOT 85 LOT AREA _____ SITE CLASS PS DESIGN FLOW 480 L.T.A.R. .3

Septic Tank: 1,000 Gallons; STB 1007 Date 4-11-02

Pump Tank: 1,000 Gallons; PT 274 Date 3-18-02

Pump Make: Zoeller Model E 140-B Serial No 140-0004

Nitrification Field: No Fields 1 Square Feet 1800 Linear Feet 300

No Lines 6 or 7 Trench Width 24" Max Trench Bottom Depth 36" ~~Gravel~~ Depth SNA 6"

☒ New System ☐ Repair System Type: I, II, III, (IV), V, VI

System Description: Pump LP - Panel Blk

Repair System Description: Pump, LP - Panel Blk

Maintenance Agreement Required: ☐ Yes ☒ No

☒ House/Mod. Home ☐ Mobile Home ☐ Business ☐ Other

No. Bedrooms 4 No. Bathrooms 4 No. Employees ____


☐ Slab ☐ Crawl Space ☒ Basement w/plumbing ☐ Basement wo/plumbing

Water Supply: ☐ Individu ☒ Public ☐ Commu


Comments:/Conditions: (1) Install Pump - PPBS System with Sim-Tech or Similar Inline Filter in Pump Tank (2) Do Not grade hill beside of Gulley on House Side (3) maintain Proper Set backs. (4) Call Health Dept to Inspect

Comments:/Conditions: System before installation. - Poly Lok Filter Installed, PT Riser Installed (1) 67 PPBS PANELS INSTALLED IN SEVEN LINES AS SHOWN BELOW W/ PRIOR HEALTH DEPT. APPROVAL

INITIAL SITE SKETCH 1"=50'

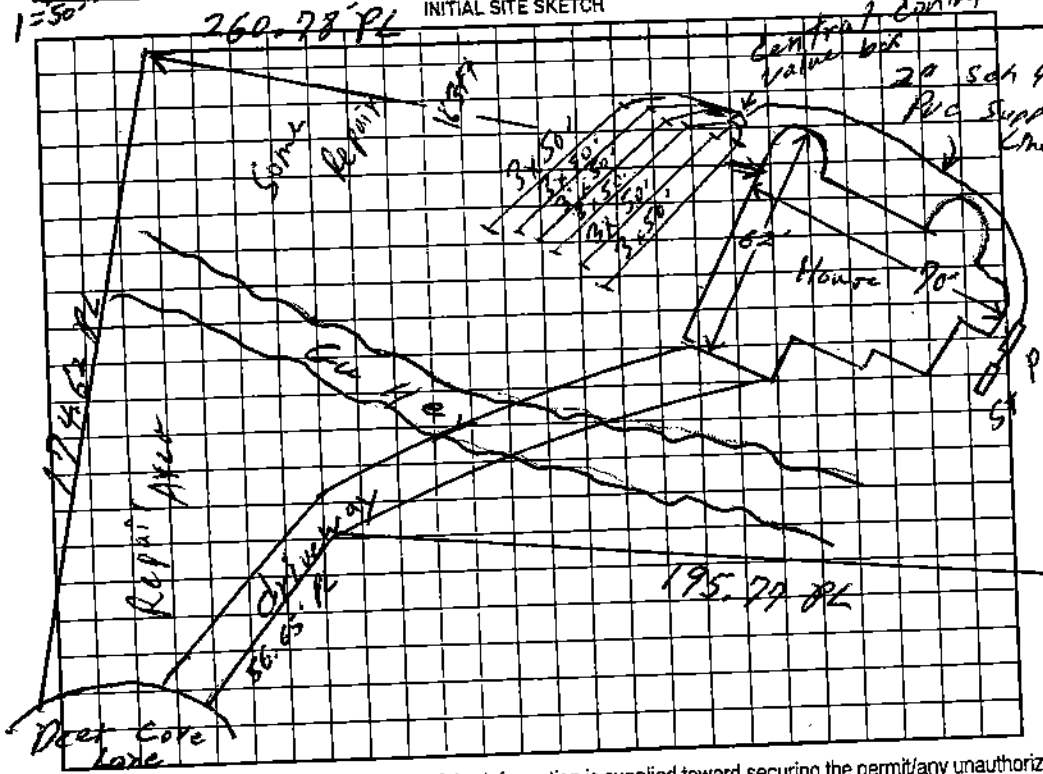

AS BUILT SKETCH — In-line Pump Filter ok — Electrical Panel, Pressure Check ok Kay, 10/1

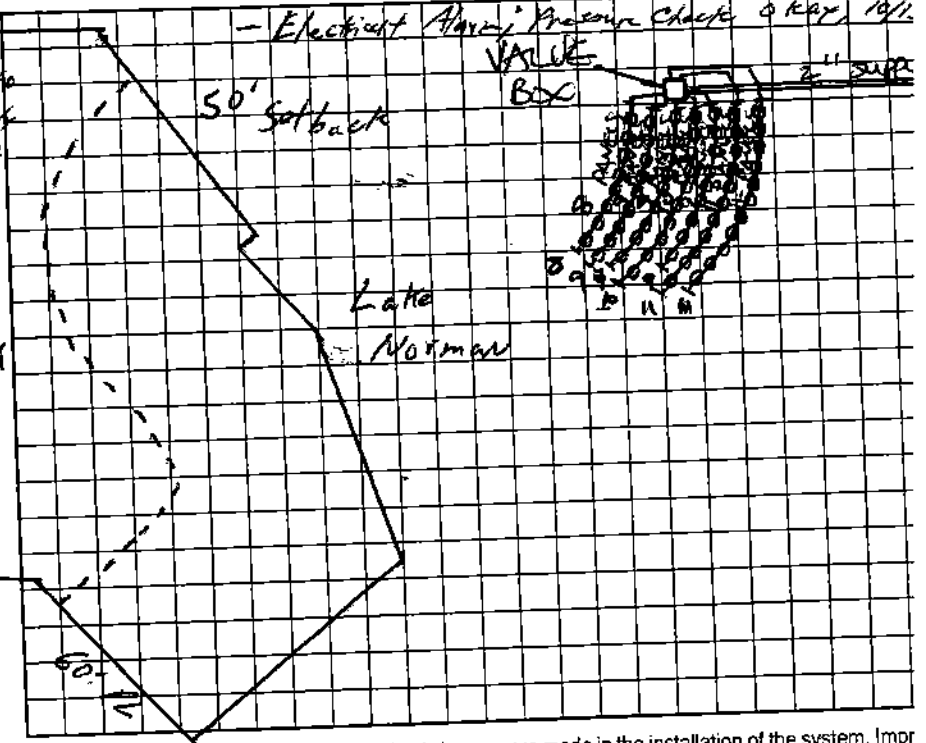

Permit can be suspended or revoked if any false information is supplied toward securing the permit/any unauthorized changes are made to the site/any unauthorized changes are made in the installation of the system. Impr

Permit with plat valid without expiration. Improvement Permit with site plan valid for sixty months. Authorization to Construct is valid for a period equal to that of Improvement Permit – not to exceed sixty months.

Signed: Randy C Welbon date 4/5/02 Installed by: WAYNE OLONTZ 12-30-03

Improvement Permit by: William O. Johnson date 4/5/02 Operation Permit by: William O. Johnson date 12/30

Authorization to Construct by: William O. Johnson date 4/5/02 Existing System Inspection by: _____ date _____

HEALTH DEPT COPY: WHITE OWNER COPY (FINAL): YELLOW OWNER COPY (INITIAL): PINK