IREDELL COUNTY HEALTH DEPARTMENT

Statesville Office (704) 878-5305 Mooresville Office (704) 660-3625 PERMIT # 204224

IMPROVEMENT PERMIT / AUTHORIZATION TO CONSTRUCT / OPERATION PERMIT / EXISTING SYSTEM

PIN # 4720514396

APPLICANT: Thomas Loftin APPLICANT ADDRESS: 181 Maple View Dr.

SITE ADDRESS: 181 Maple View Dr. PHONE: 704-902-1330 ALT. PHONE: N/A

SITE DIRECTIONS: Perth Rd to State Park Rd TL Wildlife Bay TR Sierra Woods TR Maple View

SUBDIVISION: Wildlife Bay SECTION: 2 LOT # 95 LOT AREA: 0.17 acres DESIGN FLOW: 480gpd L.T.A.R.: 0.3

Septic Tank EXISTING (gal) STB Date

Pump Tank Existing (gal) PT Date

Pump Make Goulds Model WG05T1HH Serial #

Nitrification Fields 1 # Lines 2 Linear Ft: 67

Trench Width 24" Max. Trench Bottom Depth 36" Gravel Depth N/A

☐ New System ☐ Repair ☑ Expansion System Type: I II III ☑ IV V VI

System Description: Low Pressure PPBPS

Repair System Description: Low Pressure PPBPS

Maintenance Agreement Required: ☑ YES ☐ NO

☐ GRAVITY ☑ PRESSURE

☑ Residence No. Bedrooms 4

☐ Business No. Persons 3

☐ Other No. Employees


☐ Slab ☐ Crawl Space

☑ Basement w/plumbing ☐ Basement w/o plumbing


Water Supply: ☐ Private ☑ Public ☐ Community

Comments / Conditions: Install a PPBPS on contour with parallel distribution. Set new control value box at location shown below & connect drainfield as shown. Use same hole size as existing lines. Relocate waterline a min. of 10' from all components of septic system & repair area.

INITIAL SITE SKETCH

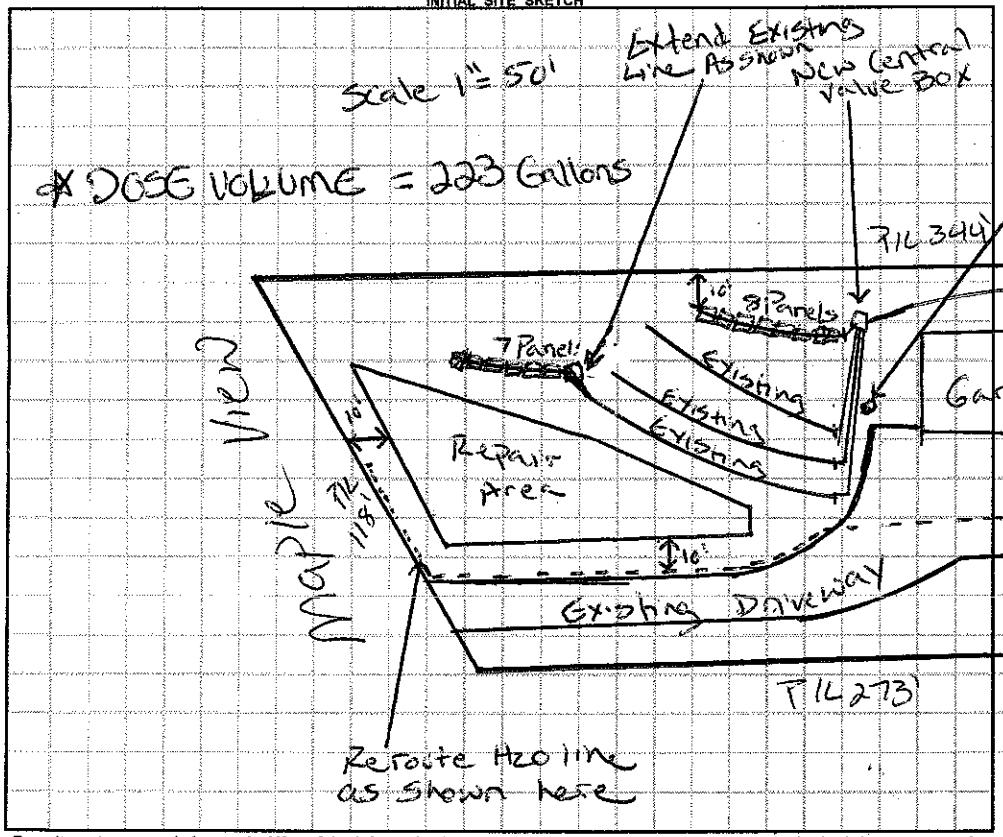

AS BUILT SKETCH

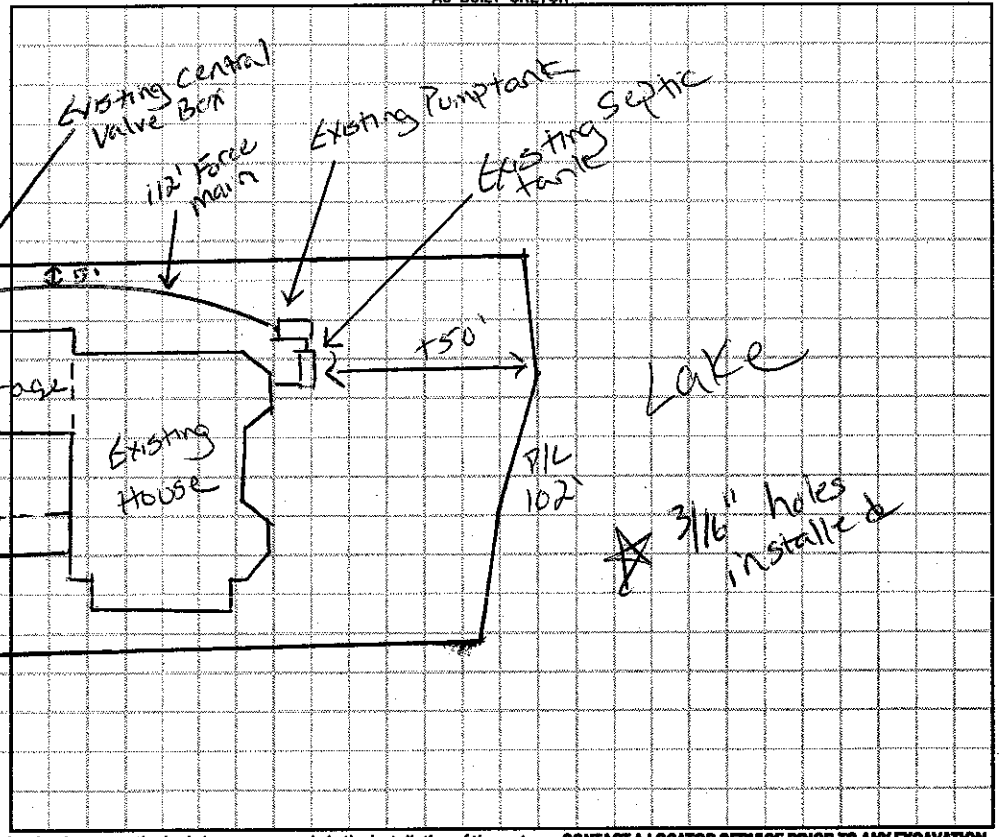

Permit can be suspended or revoked if any false information is supplied toward securing the permit / any unauthorized changes are made to the site / any unauthorized changes are made in the installation of the system. **CONTACT A LOCATOR SERVICE PRIOR TO ANY EXCAVATION**

☐ **IMPROVEMENT PERMIT** *with plat valid without expiration.* ☑ **IMPROVEMENT PERMIT** *with site plan valid for 60 mos.* ☑ **AUTHORIZATION TO CONSTRUCT** *valid for period equal to IMPROVEMENT PERMIT--not to exceed 60 mo.*

Owner / Applicant Signature: Thomas Loftin Date: 8-4-14 Installed by: Steve Jordan

IMPROVEMENT PERMIT by: Justin Newsome Date: 8-1-14 OPERATION PERMIT by: Justin Newsome Date: 9-2-14

AUTHORIZATION TO CONSTRUCT by: Justin Newsome Date: 8-1-14 Existing System Inspected by: Date:

Health Dept. Copy - WHITE Applicant (Final Approval) - YELLOW Applicant (Conditional Approval) - PINK