IREDELL COUNTY HEALTH DEPARTMENT

776-3427 905-6704

315.00 Paid

STATESVILLE 704-878-5305 MOORESVILLE 704-664-5281

IMPROVEMENT PERMIT / AUTHORIZATION TO CONSTRUCT / OPERATION PERMIT / EXISTING SYSTEM INSPECTION

PERMIT# 120401 PIN# 4720514396

OWNER OR CONTRACTOR KENT SHAW PHONE: Business 528-4421 Home

ADDRESS PO BOX 1061 TROUTMAN NC 28166 DATE 5/12/04

LOCATION PERTH SOUTH - TR STATE PARK - TL WILDLIFE - TR SIERRA WOODS - TR MAPLE VIEW - AT END

SUBDIVISION WILDLIFE BAY BLOCK / SECTION II LOT 95 LOT AREA SITE CLASS. PS DESIGN FLOW 360.00 L.T.A.R. .30/.72

Septic Tank: 1000 Gallons: STB 794 Date 12-14-04

Pump Tank: 1000 Gallons: PT 27 Date 12-12-04

Pump Make: MYERS Model MU50-11P Serial No. 2688D901

Nitrification Field: No Fields 1 Square Feet 410 Linear Feet 205

No Lines 3 Trench Width 24" Max Trench Bottom Depth 30" Gravel Depth MIN

☑ New System ☐ Repair System Type: I, II, III, IV, V, VI

System Description: LL PANEL

Repair System Description: SAME

Maintenance Agreement Required: ☐ Yes ☐ No

☑ House/Mod. Home No. Bedrooms 3

☐ Mobile Home No. Bathrooms 3

☐ Business No. Employees

☐ Other

☐ Slab ☐ Crawl Space ☑ Basement w/plumbing ☐ Basement w/o plumbing

Water Supply: ☐ Individual ☐ Public ☐ Community

Comments/Conditions:


PT

Comments/Conditions: POLYLOK FILTER + RISER ON PT + MARKER DUST


OWNER SAYS MOVES [redacted] ALL BEYOND 50' SEPTIC

V.D. JAMES 12-05

INITIAL SITE SKETCH 1"=40'

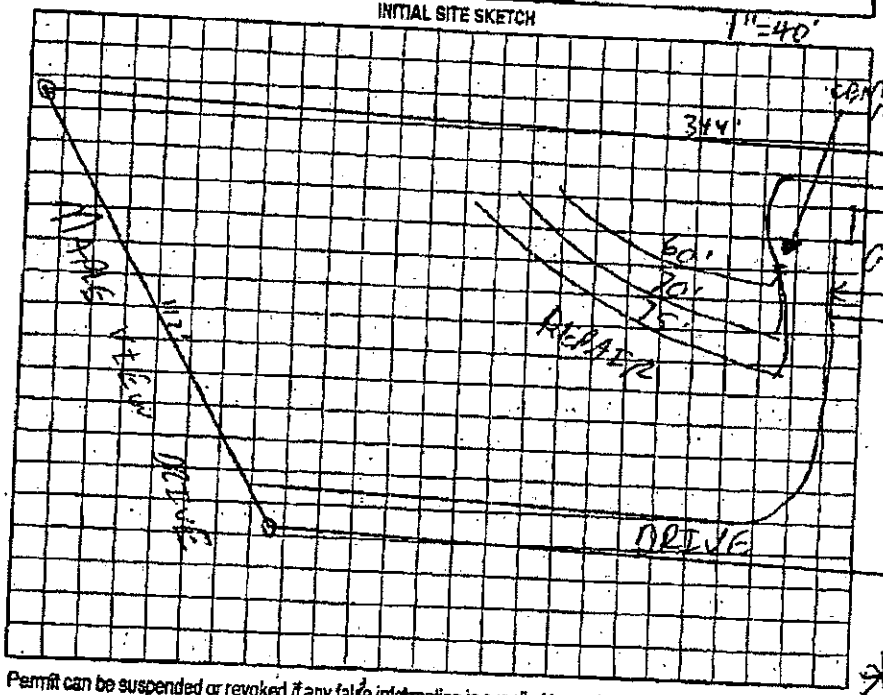

AS BUILT SKETCH

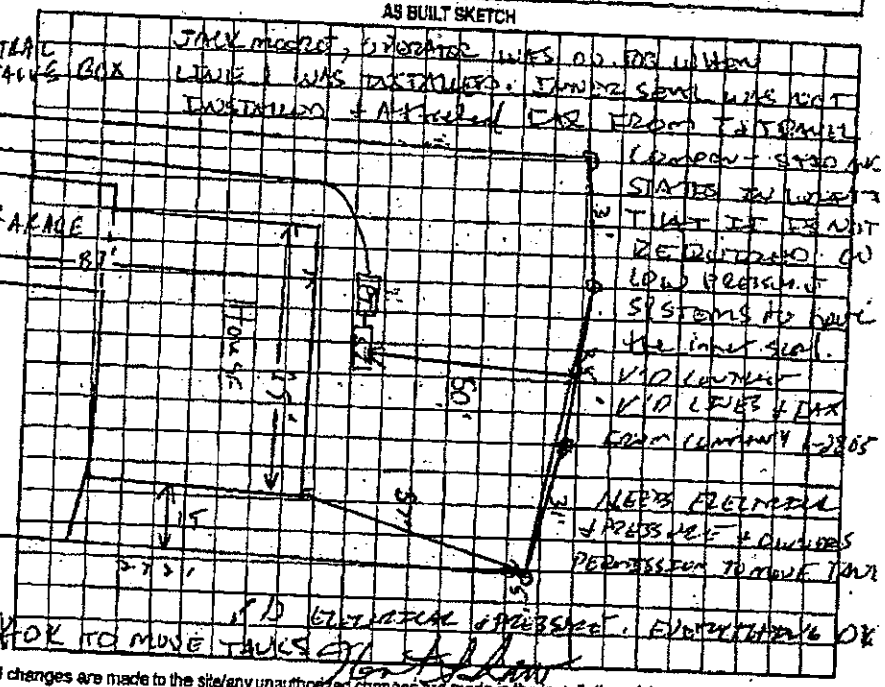

Permit can be suspended or revoked if any false information is supplied toward securing the permit/any unauthorized changes are made to the site/any unauthorized changes are made in the installation of the system. Improvement Permit with plat valid without expiration. Improvement Permit with site plan valid for sixty months. Authorization to Construct is valid for a period equal to that of Improvement Permit – not to exceed sixty months.

Signed: [signature] date 5/12/04

Improvement Permit by: [signature] RS date 5/12/04

Authorization to Construct by: [signature] RS date 5/12/04

HEALTH DEPT COPY-WHITE

Installed by: JAMES WOOLEN

Operation Permit by: [signature] RS date 3-14-05

Existing System Inspection by: date