IREDELL COUNTY HEALTH DEPARTMENT

STATESVILLE 704-878-5305 MOORESVILLE 704-664-5281

125

IMPROVEMENT PERMIT / AUTHORIZATION TO CONSTRUCT / OPERATION PERMIT / EXISTING SYSTEM INSPECTION

PERMIT# 077026 PIN# 4639744550 Properties (336)345-7072 DATE 3-26-99

OWNER OR CONTRACTOR Crescent Resources Inc. // CAPRON PHONE: Business Lots 3-6905 Home 336-682-7374 ICENT PARKER

ADDRESS P.O. Box 1003 Charlotte NC 28201 // P.O. Box 1308 Clemmons 27012

LOCATION State Park Rd TL Wildlife TR Sierra Woods TR Maple View

SUBDIVISION Wildlife Bay BLOCK / SECTION II LOT 100/100A LOT AREA 41,853 ft² SITE CLASS PS DESIGN FLOW 480 gpd L.T.A.R.

Septic Tank: 1000 Gallons; STB 794 Date 2/27/01

Pump Tank: 1000 Gallons; PT 2810 Date 3/4/01

Pump Make: Goulds Model WE10121 Serial No. B0043272

Nitrification Field: No Fields 1 Square Feet 1200 Linear Feet 400

No Lines 4 at 100' Trench Width 36" Max Trench Bottom Depth 36" Gravel Depth

X New System ☐ Repair System Type: I, II, (III), IV, V

System Description: Pump (pm) 25% Reduction

Repair System Description: Pump - Modified

Maintenance Agreement Required: ☐ Yes X No

X House/Mod. Home No. Bedrooms 4

☐ Mobile Home No. Bathrooms 4

☐ Business No. Employees

☐ Other

☐ Slab ☐ Crawl Space X Basement w/plumbing ☐ Basement wo/plumbing

Water Supply: ☐ Individual X Public ☐ Community

Comments/Conditions: Keep Septic System at least 10' from PL & 50' from lake


Nov. 7,00 Reviewed house & site plan - OK to have right side load garage

Comments/Conditions: 4/6/01 - LINES CHECKED, NEEDS PUMP INSPECTION.


5/4/01 - CHECKED PUMP AND SET FLOW NEEDS ELECTRICAL ENSPECTION.

6-15-0 ELECTRICAL ✓ OK!

INITIAL SITE SKETCH Scale = 1:50

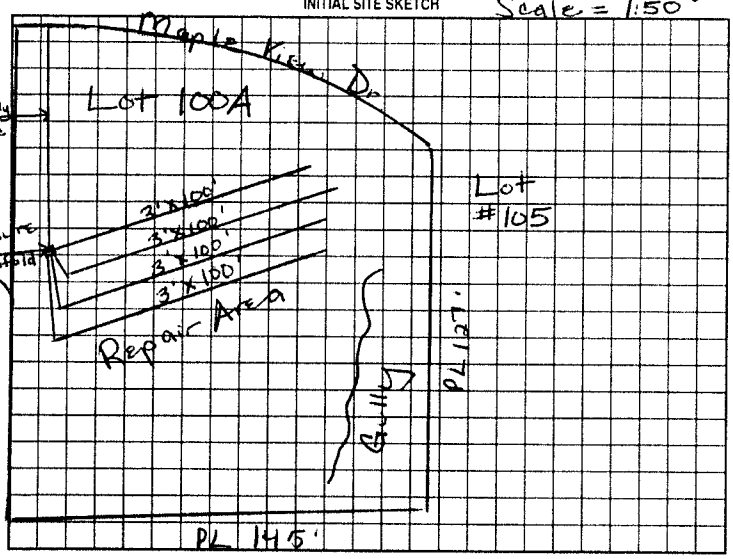

AS BUILT SKETCH

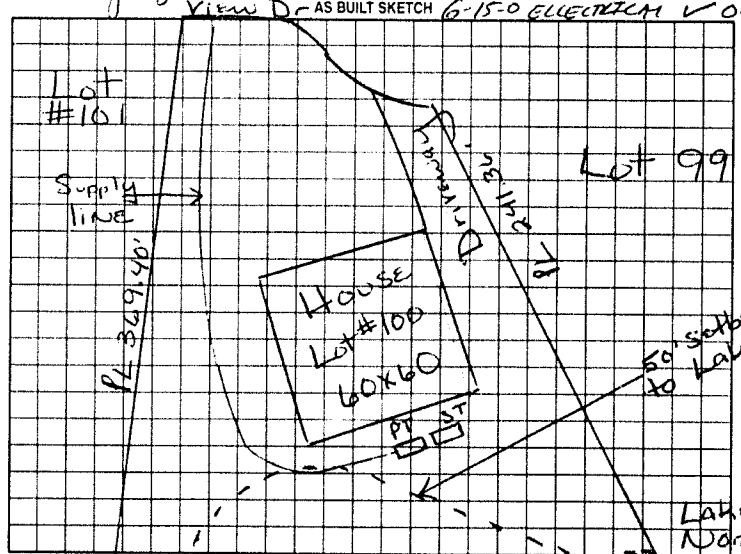

Permit can be suspended or revoked if any false information is supplied toward securing the permit/any unauthorized changes are made to the site/any unauthorized changes are made in the installation of the system. Improvement Permit with plat valid without expiration. Improvement Permit with site plan valid for sixty months. Authorization to Construct is valid for a period equal to that of Improvement Permit - not to exceed sixty months.

Signed: [signature] date 4/13/99 Installed by: F. J. ERVIN

Improvement Permit by: [signature] date 3/26/99 Operation Permit by: [signature] date 5/4/01

Authorization to Construct by: [signature] date 11/7/00 Existing System Inspection by: date

HEALTH DEPT COPY WHITE OWNER COPY (FINAL) YELLOW OWNER COPY (INITIAL) PINK