IREDELL COUNTY HEALTH DEPARTMENT

STATESVILLE 704-878-5305 MOORESVILLE 704-664-5281

IMPROVEMENT PERMIT / AUTHORIZATION TO CONSTRUCT / OPERATION PERMIT / EXISTING SYSTEM INSPECTION

7-20 14-60 46-200 46 14 60

PERMIT# 130539 PIN# 4720516290 DATE 12-9-05

OWNER OR CONTRACTOR KOEHLER HOMES, DOC PHONE: Business 704-309-0227 Home 704-528-1235

ADDRESS 118 HAWK RUN LANE TROUTMAN, NC 28166

LOCATION 21 SOUTH (R) PERTH (R) State Park (L) Wildlife (R) Sierra Woods (R) Maple View LOT ON LEFT BY CUL-DE-SAC

SUBDIVISION Wildlife Bay BLOCK / SECTION LOT 92 LOT AREA 1.21 AC SITE CLASS. PS DESIGN FLOW 480 L.T.A.R. .3

Septic Tank: 1000 Gallons; STB 312 Date 28 DAYS + Pump Tank: 1000 Gallons; PT 283 Date 28 DAYS + Pump Make: GOULDS Model WE0 2012 Serial No. Nitrification Field: No Fields 1 Square Feet 270 = 1600 Linear Feet 270' No Lines 6x45' Trench Width 24" Max Trench Bottom Depth 36" Gravel Depth N/A

☒ New System ☐ Repair System Type: I, II, ⓘ IV, V, VI

System Description: PUMP 50% REDUCTION

Repair System Description: LP 50% REDUCTION

Maintenance Agreement Required: ☐ Yes ☒ No

☒ House/Mod. Home ☐ Mobile Home ☐ Business ☐ Other

No. Bedrooms 4 No. Bathrooms 3 No. Employees

☐ Slab ☐ Crawl Space ☒ Basement w/plumbing ☐ Basement wo/plumbing


Water Supply: ☐ Individual ☐ Public ☒ Community

Comments:/Conditions: ① INSTALL SUPPLY LINE 36" DEEP & SLEEVE UNDER DRIVEWAY ② INSTALL LINES ON CONTOUR & MAINTAIN SETBACK, ESPECIALLY FROM PERKS & RETAINING WALLS. ③ STUBOUT FOR TANKS MUST BE AT BASEMENT TO DAYLIGHT SIDE SO SEPTIC IS


Comments:/Conditions: CAN BE MAINTAINED. ① USE PRESSURE MANIFOLD TO 6 LINES / 45' LONG AS DRAWN ② CALL PRIOR TO INSTALLATION FOR SYSTEM SPECS IF RELEASED.

1" = 50'

INITIAL SITE SKETCH

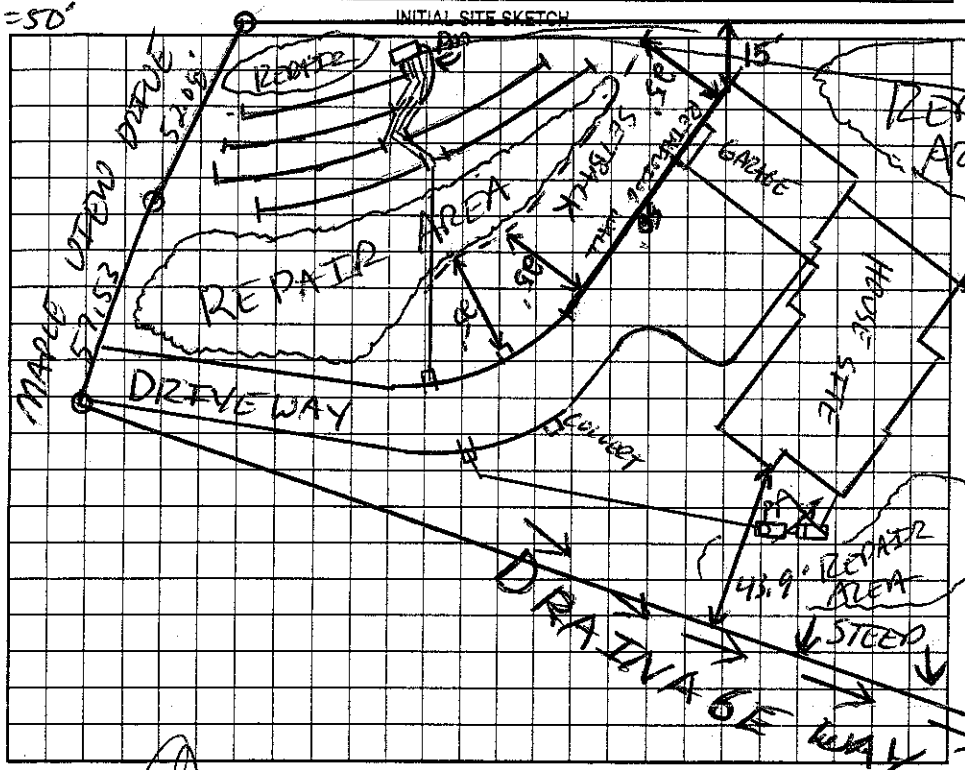

AS BUILT SKETCH

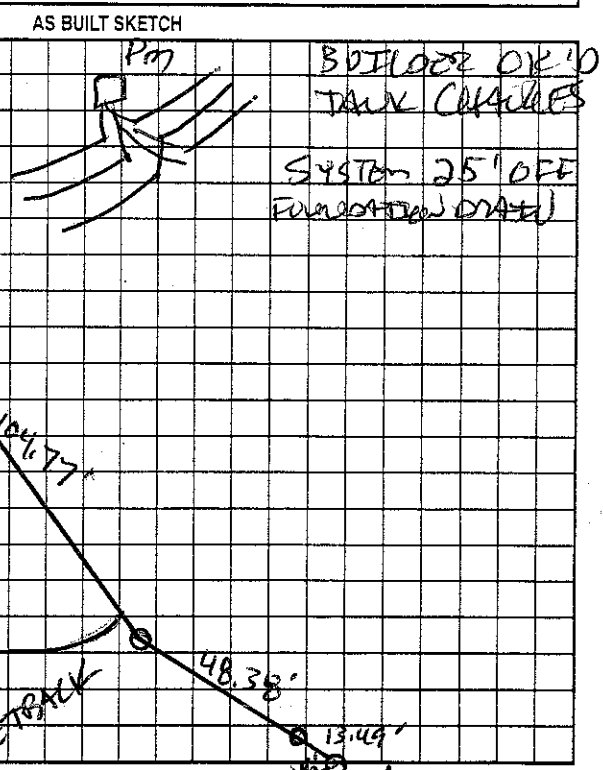

Permit can be suspended or revoked if any false information is supplied toward securing the permit/any unauthorized changes are made to the site/any unauthorized changes are made in the installation of the system. Improvement Permit with plat valid without expiration. Improvement Permit with site plan valid for sixty months. Authorization to Construct is valid for a period equal to that of the Improvement Permit not to exceed sixty months.

Signed: date 12-9-05 Installed by: CURT

Improvement Permit by: date 12-9-05 Operation Permit by: date 7-18-06

Authorization to Construct by: date 12-9-05 Existing System Inspection by: date

HEALTH DEPT. COPY: WHITE OWNER COPY (FINAL): YELLOW OWNER COPY (INITIAL): PINK