IREDELL COUNTY HEALTH DEPARTMENT

STATESVILLE 704-878-5305 MOORESVILLE 704-664-5281

IMPROVEMENT PERMIT / AUTHORIZATION TO CONSTRUCT / OPERATION PERMIT / EXISTING SYSTEM INSPECTION

PERMIT# 122392 PIN# 4720-51-6774 DATE 7-20-04

OWNER OR CONTRACTOR PRESTIGE PREMIER HOME BLDRS, INC PHONE: Business (704) 528-3999 Home

ADDRESS PO BOX 749 TROUTMAN NC 28166

LOCATION STATE PARK RD (L) WILDLIFE RD (R) SIERRA WOODS (R) MAPLE VIEW LOT AT END ON RIGHT (184 MAPLEVIEW)

SUBDIVISION WILDLIFE BAY BLOCK / SECTION II LOT 101 LOT AREA 1.18 SITE CLASS PS DESIGN FLOW 480 L.T.A.R. 0.3 GPD/FT²

Septic Tank: 1000 Gallons; STB 1012 Date 28 DAYS

Pump Tank: 1000 Gallons; PT 17 Date 28 DAYS

Pump Make: ZOELLER Model N-161-E Serial No. 161-0402

Nitrification Field: No Fields 1 Square Feet 1600 Linear Feet 270

No Lines 3 Trench Width 24" Max Trench Bottom Depth 36"

☑ New System ☐ Repair System Type: I, II, III, (IV) V, VI

System Description: LP 50% RED PPBPS

Repair System Description: SAME

Maintenance Agreement Required: ☑ Yes ☐ No

Gravel Depth 2" SAND

☑ House/Mod. Home No. Bedrooms 4

☐ Mobile Home No. Bathrooms

☐ Business No. Employees

☐ Other


☐ Slab ☑ Crawl Space ☐ Basement w/plumbing ☐ Basement wo/plumbing

Water Supply: ☐ Individual ☐ Public ☑ Community


Comments:/Conditions: (1) INSTALL LINES 36" ON CONTOUR (2) SMOOTH OUT ROUGH TOPO (3) RAKE/LIME TRENCH WALLS (3) MAINTENANCE AGREEMENT NEED (4) SYSTEM REQUIRES (42) PANELS (4) CALL PRIOR TO INSTALLATION FOR SYSTEM SPECS & PUMP STRING IF NECESSARY

Comments:/Conditions: V'D LINES & PANELS ON PLANS CONTROL VALVE BOX SET BETWEEN 1ST & 2ND DRIVE, DRIVE NEEDS A CHECK VALVE, SET PRESSURE ALSO.

INITIAL SITE SKETCH SCALE 1" = 60'

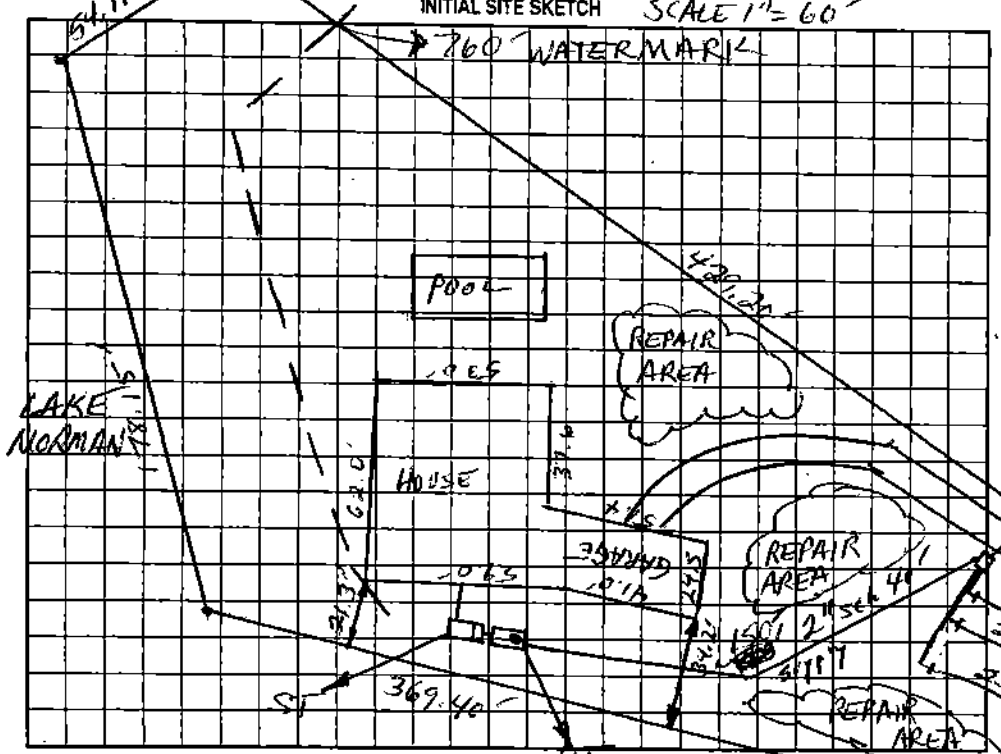

AS BUILT SKETCH

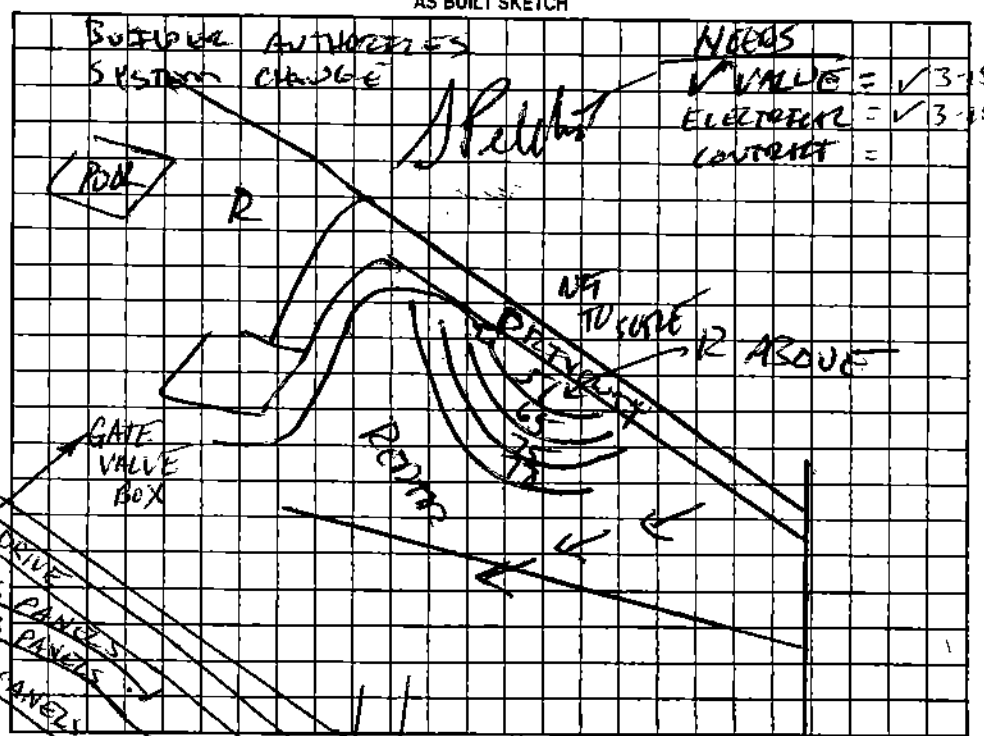

Permit can be suspended or revoked if any false information is supplied toward securing the permit/any unauthorized changes are made to the site/any unauthorized changes are made in the installation of the system. Improvement Permit with plat valid without expiration/ Improvement Permit with site plan valid for sixty months. Authorization to Construct is valid for a period equal to that of Improvement Permit – not to exceed sixty months.

Signed: [signature] date 7-21-04

Improvement Permit by: Christopher M Shirell, PS date 7-20-04

Authorization to Construct by: Christopher M Shirell, PS date 7-21-04

Installed by: [signature] date 3-16-05

Operation Permit by: [signature] date

Existing System Inspection by: date

HEALTH DEPT. COPY: WHITE OWNER COPY (FINAL): YELLOW OWNER COPY (INITIAL): PINK