IREDELL COUNTY HEALTH DEPARTMENT

STATESVILLE 704-878-5305 MOORESVILLE 704-664-5281

IMPROVEMENT PERMIT / AUTHORIZATION TO CONSTRUCT / OPERATION PERMIT / EXISTING SYSTEM INSPECTION

PERMIT# 123732 PIN# 4720-51-7655 DATE 9-29-04

OWNER OR CONTRACTOR DARREL TIBBS PHONE: Business 757-343-5080 Home 704-309-0227

ADDRESS TERRELL, NC 28682 5061 LEE POINT

LOCATION 21 SOUTH (E) PERTH (E) STATE PRK (L) WILDLK (R) SIERRA WOODS (R) COMPLETION PT @ LOT #102

SUBDIVISION WILDLK BAY BLOCK / SECTION # LOT 102 LOT AREA 36,722 sq ft SITE CLASS PS DESIGN FLOW 480 L.T.A.R. .3

Septic Tank: 1000 Gallons; STB 317 Date 2-19-04
Pump Tank: 1000 Gallons; PT 285 Date 1-24-05
Pump Make: GOULDS Model WE0512HH0 Serial No.
Nitrification Field: No Fields 1 Square Feet EQ-600' Linear Feet 400'
No Lines 4X100' Trench Width 36" Max Trench Bottom Depth 36"

☒ New System ☐ Repair System Type: I, II, (III), IV, V, VI
System Description: PUMP 25% REDUCT
Repair System Description: LP 50% REDUCT
Maintenance Agreement Required: ☐ Yes ☒ No

☒ House/Mod. Home ☐ Mobile Home ☐ Business ☐ Other
No. Bedrooms 4 No. Bathrooms 3½ No. Employees


Water Supply: ☐ Individual ☐ Public ☒ Community

Gravel Depth N/A ☐ Slab ☐ Crawl Space ☒ Basement w/plumbing ☐ Basement wo/plumbing


Comments/Conditions: (1) NOTE HEADSIDE COMMENTS & SUPPLY LINE COMMENTS. [redacted] (2) DRIVEWAY WILL BE INSTALLED AFTER SEPTIC; INSTRUCTIONS FROM BUILDER.

Comments/Conditions: (3) INSTALL LINES ON CONTOURS & MAINTAIN SETBACKS (4) CALL PRIOR TO INSTALLATION FOR PUMP SIZING & SYSTEM SPECS IF NECESSARY. POLYDOME FILTER TRENCHES

INITIAL SITE SKETCH

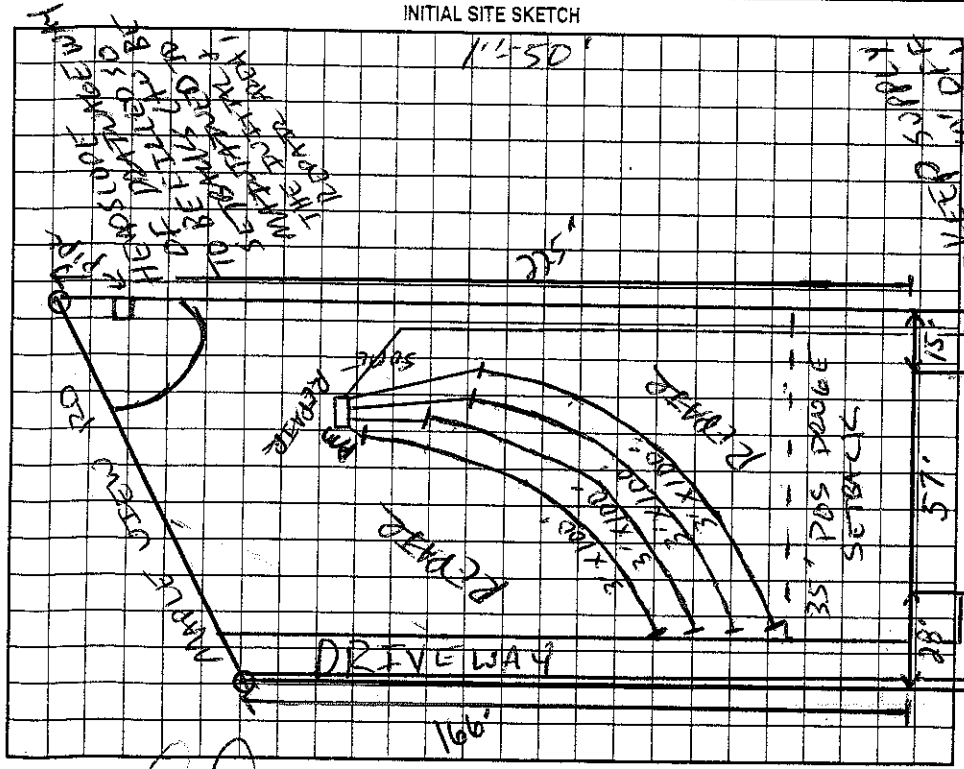

AS BUILT SKETCH

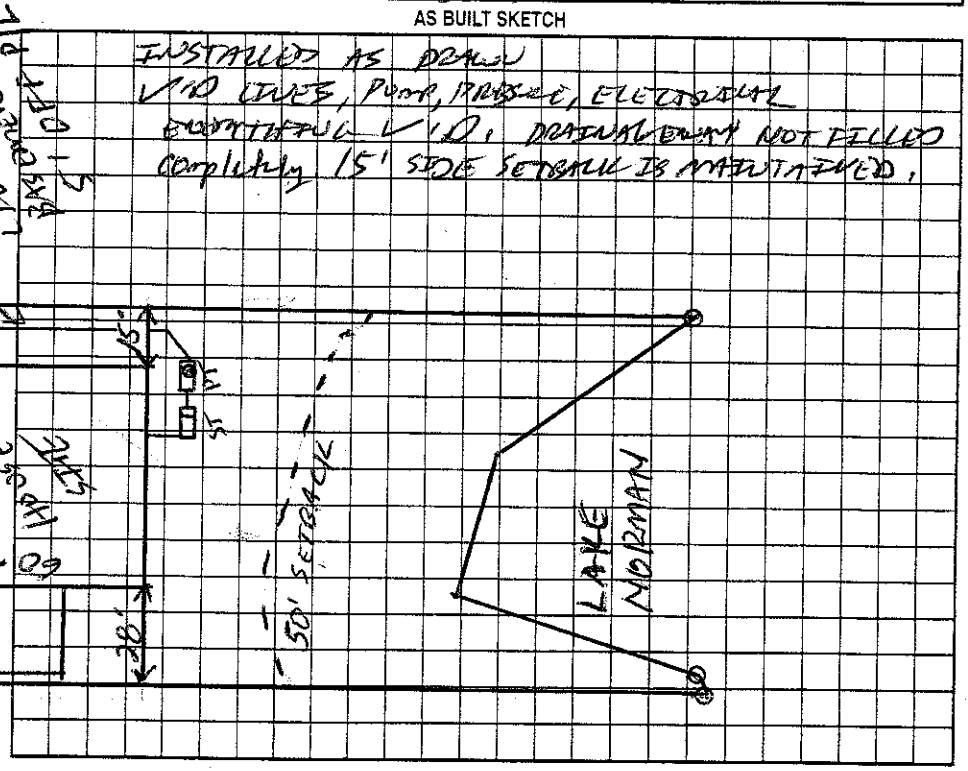

Permit can be suspended or revoked if any false information is supplied toward securing the permit/any unauthorized changes are made to the site/any unauthorized changes are made in the installation of the system. Improvement Permit with plat valid without expiration. Improvement Permit with site plan valid for sixty months. Authorization to Construct is valid for a period equal to that of Improvement Permit – not to exceed sixty months.

Signed: _____ date _____ Installed by: CURT DUNNING

Improvement Permit by: _____ date 9-29-04 Operation Permit by: _____ date 4-5-05

Authorization to Construct by: _____ date 9-29-04 Existing System Inspection by: _____ date _____

HEALTH DEPT. COPY: WHITE OWNER COPY (FINAL): YELLOW OWNER COPY (INITIAL): PINK