IREDELL COUNTY HEALTH DEPARTMENT

STATESVILLE 704-878-5305 MOORESVILLE 704-664-5281

125

IMPROVEMENT PERMIT / AUTHORIZATION TO CONSTRUCT / OPERATION PERMIT / EXISTING SYSTEM INSPECTION

PERMIT# 077029 PIN# [4726]39783[illegible] 4726-51-8662 DATE 2/26/99

OWNER OR CONTRACTOR Crescent Resources PHONE: Business 663-6905 Home

ADDRESS P.O. Box 1003 Charlotte, NC 28201

LOCATION State Park TC Wildlife TR Sierra Woods TR Maple View

SUBDIVISION Wild Life Bay BLOCK / SECTION II LOT 103 LOT AREA 39,310 ft² SITE CLASS PS DESIGN FLOW 480gpd L.T.A.R. .3

Septic Tank: 1000 Gallons; ST 1012 Date 03/08/02

Pump Tank: 1000 Gallons; PT 1017 Date 04/19/02

Pump Make: GOULDS Model WE10121H4 Serial No. J026345

Nitrification Field: No Fields 1 Square Feet 1200' Linear Feet 400'

No Lines 5 at 80' Trench Width 36" Max Trench Bottom Depth 36" Gravel Depth N/A

☒ New System ☐ Repair System Type: I, II, III, IV, V, VI

System Description: Pump - PM - 25% Reduction

Repair System Description: Pump - Panel

Maintenance Agreement Required: ☐ Yes ☒ No

☒ House/Mod. Home ☐ Mobile Home ☐ Business ☐ Other

No. Bedrooms 4 No. Bathrooms 4 No. Employees


☐ Slab ☐ Crawl Space ☒ Basement w/plumbing ☐ Basement wo/plumbing

Water Supply: ☐ Individual ☒ Public ☐ Community

Comments:/Conditions: Keep Septic System at least 10' from PL & 50' from lake


Comments:/Conditions: - SEPTIC TANK INSTALLED with marker & Polylock Filter

INITIAL SITE SKETCH Scale 1:50

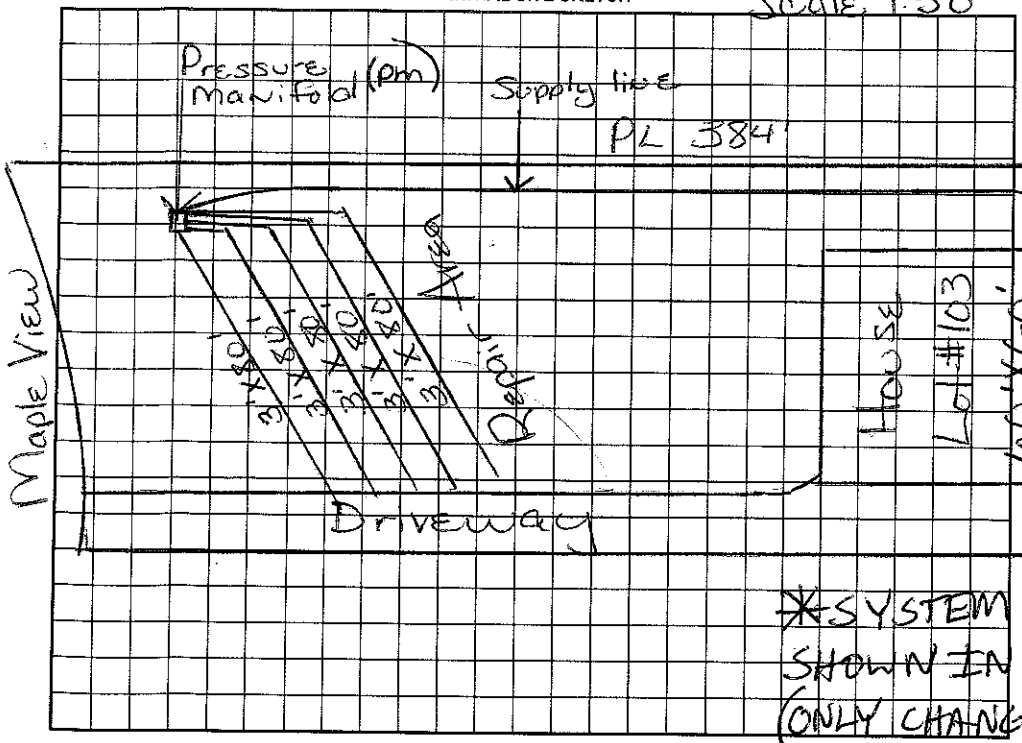

AS BUILT SKETCH

* TANKS CHECKED 07/15/02 PM

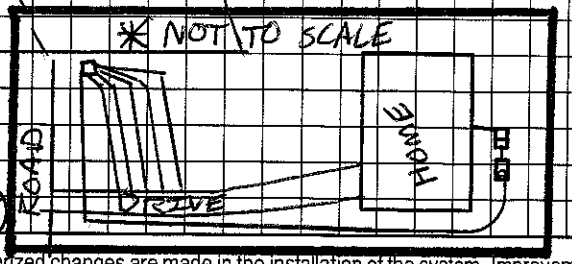

*SYSTEM INSTALLED AS SHOWN IN INITIAL SKETCH, (ONLY CHANGES: TANKS & SUPPLY LINE)

Permit can be suspended or revoked if any false information is supplied toward securing the permit/any unauthorized changes are made to the site/any unauthorized changes are made in the installation of the system. Improvement Permit with plat valid without expiration. Improvement Permit with site plan valid for sixty months. Authorization to Construct is valid for a period equal to that of Improvement Permit – not to exceed sixty months.

Signed: [signature] date 4/15/99 Installed by: Steve Jordan - 02/05/03

Improvement Permit by: Maria H. Dotson date 2/26/99 Operation Permit by: [signature] date 02/27/03

Authorization to Construct by: [signature] date 4/10/02 Existing System Inspection by: date

HEALTH DEPT. COPY: WHITE OWNER COPY (FINAL): YELLOW OWNER COPY (INITIAL): PINK