JEFF LANCASTER

IREDELL COUNTY HEALTH DEPARTMENT

THIS PERMIT VOIDS PREVIOUS ISSUED 6-21-2001 11/11/02

STATESVILLE 704-878-5305 MOORESVILLE 704-664-5281

IMPROVEMENT PERMIT / AUTHORIZATION TO CONSTRUCT / OPERATION PERMIT / EXISTING SYSTEM INSPECTION

PERMIT# 07025 PIN# ~~4639 73 4550~~ 4720-51-3647/4720-51-9093 DATE 1-4-02

OWNER OR CONTRACTOR CRESCENT RESOURCES PHONE Business (704) 643-6905 Home

ADDRESS P.O. BOX 1003 CHARLOTTE NC 28201

LOCATION STATE PARK ROAD, TL WILDLIFE, TR SIERRA WOODS, TR MAPLE VIEW, LOT AT END ON RIGHT

SUBDIVISION WILDLIFE PARK BLOCK / SECTION II LOT 77, 77A LOT AREA 2.15 ACRES SITE CLASS 1 DESIGN FLOW 450 L.T.A.R. 0.38 SPD/FT²

Septic Tank: 1000 Gallons STB 794 Date 11-6-01

Pump Tank: 1000 Gallons PT 283 Date 11-13-01

Pump Make: GOULDS Model WE 3CC2 11 Serial No 2012H220

Nitrification Field: No Fields 1 Square Feet Req. 1600 Linear Feet 270

No Lines FOUR Trench Width 24" Max Trench Bottom Depth 36" Gravel Depth SAND 6"

☑ New System ☐ Repair System Type: I II III ⓘ IV V

System Description 50% REDUCTION, LOW PRESS.

Repair System Description 50% REDUCTION, LOW PRESS.

Maintenance Agreement Required: ☑ Yes ☐ No

☑ House/Mod Home No Bedrooms 4

☐ Mobile Home No Bathrooms 3½

☐ Business No Employees

☐ Other


☐ Slab ☐ Crawl Space ☑ Basement w/plumbing ☐ Basement w/o plumbing

Water Supply: ☐ Individual ☑ Public ☐ Community


Comments/Conditions ① INSTALL 62 PPBI'S PANELS IN FOUR LINES AS SHOWN USING PRESSURE DOSING DISTRIBUTION ② SEE ATTACHED SHEETS FOR PUMP & LOW PRESSURE DISTRIBUTION ③ A CONTRACT SHALL AS EXECUTED BETWEEN

Comments/Conditions SYSTEM OWNER & A MANAGEMENT ENTITY PRIOR TO ISSUANCE OF OPERATION PERMIT ④ USE IN-LINE PUMP FILTER SUCH AS "GAS SAVER/TECH" IN PUMP TANK

INITIAL SITE SKETCH

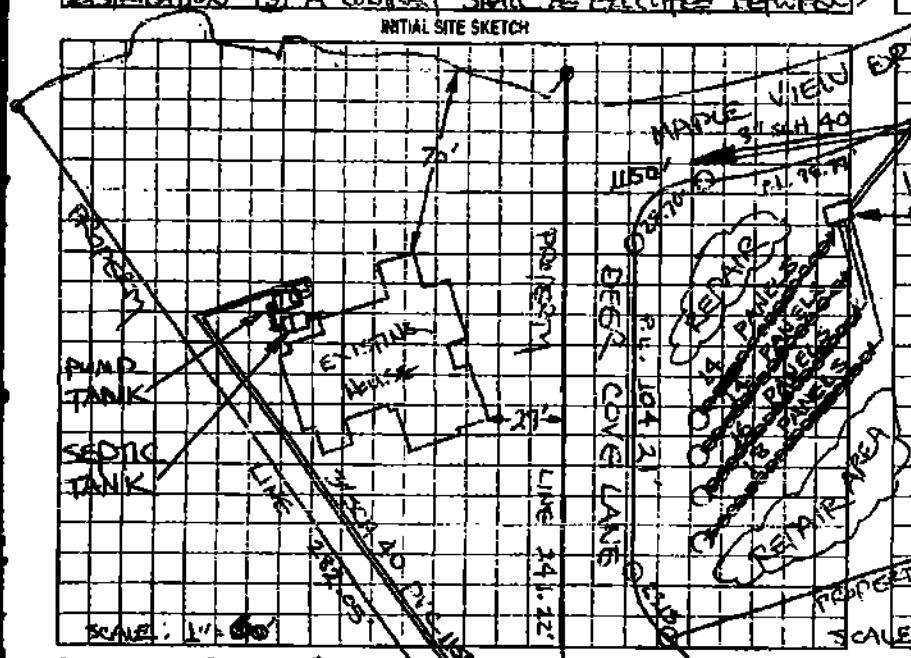

AS BUILT SKETCH

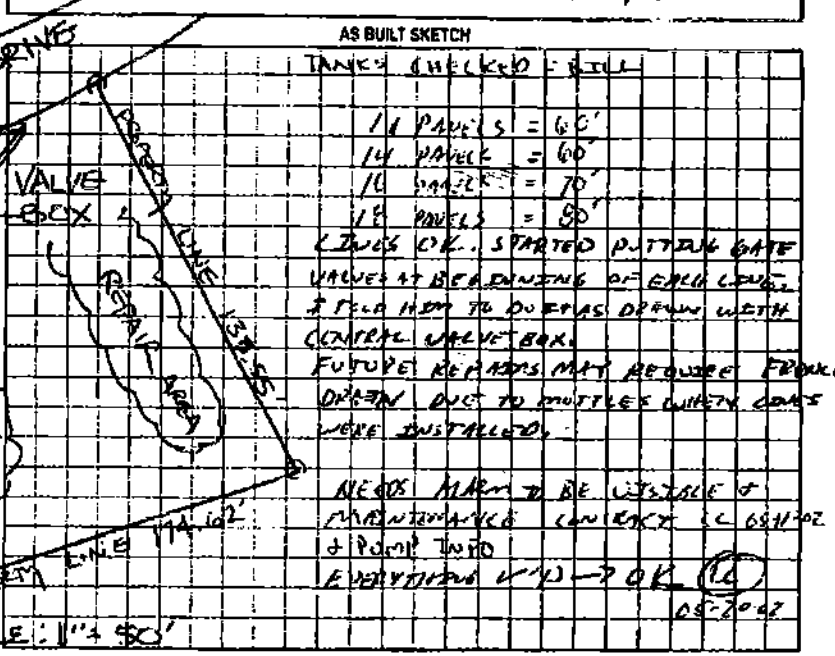

Permit can be suspended or revoked if any false information is supplied toward securing the permit-any unauthorized changes are made to the site any unauthorized changes are made in the installation of the system. Improvement Permit with plat valid without expiration. Improvement Permit with site plan valid for sixty months. Authorization to Construct is valid for a period equal to that of Improvement Permit – not to exceed sixty months.

Signed: _____ date 1/14/02 Installed by: KURT DUNNING

Improvement Permit by: STEVE HEDRICK date 1-4-02 Operation Permit by: _____ date 05-20-02

Authorization to Construct by: STEVE HEDRICK date 1-4-02 Existing System Inspection by: _____ date _____

HEALTH DEPT COPY WHITE OWNER COPY (FINAL) YELLOW OWNER COPY (INITIAL) PINK

JAN. 4, 1989 6:06