IREDELL COUNTY HEALTH DEPARTMENT

STATESVILLE 704-878-5305 MOORESVILLE 704-664-5281

IMPROVEMENT PERMIT / AUTHORIZATION TO CONSTRUCT / OPERATION PERMIT / EXISTING SYSTEM INSPECTION

PERMIT# 11981 PIN# 4720-51-9569 704 OSCAR DATE 5/17/04

OWNER OR CONTRACTOR Kaepler Homes Inc PHONE: Business 289-0227 Home (704) 528-1235

ADDRESS 118 Hawk Run Lane Troutman N.C 28166

LOCATION State Park Rd (2) Wildlife (2) Sierra Woods (2) Mock Woods on Right

SUBDIVISION Wildlife Bay BLOCK / SECTION ____ LOT 104 LOT AREA .99 Ac SITE CLASS. PS DESIGN FLOW 480 L.T.A.R. .3060/.342

Septic Tank: 4000 Gallons; STB 312 Date 5-28-04
Pump Tank: 4000 Gallons; PT 27 Date 5-27-04
Pump Make: Zoeller Model W607/2 Serial No. 5055291772
Nitrification Field: No Fields 1 Square Feet 1600 Linear Feet 400
No Lines 4 @ 100' Trench Width 36" Max Trench Bottom Depth 36" Gravel Depth N/A

☒ New System ☐ Repair System Type: I, II, (III) IV, V, VI
System Description: Pump 25% Reduction
Repair System Description: Pump 50% Reduction
Maintenance Agreement Required: ☐ Yes ☒ No

☒ House/Mod. Home No. Bedrooms 4
☐ Mobile Home No. Bathrooms 4
☐ Business No. Employees ____
☐ Other ____


☐ Slab ☐ Crawl Space ☒ Basement w/plumbing ☐ Basement wo/plumbing

Water Supply: ☐ Individual ☒ Public ☐ Community


Comments/Conditions: (1) monitor pump set Floats (2) H2O line must be 10' from Septic Lines

Comments/Conditions: V/D TANKS ON 6-30-04. BUILDER INITIALED TANK CHANGES & PLAT ATTACHED OF HOUSE LOCATION & TANK PLACEMENT TO SCALE. LL 6-30-04 Septic lines okay 12-8-04 wgl

INITIAL SITE SKETCH

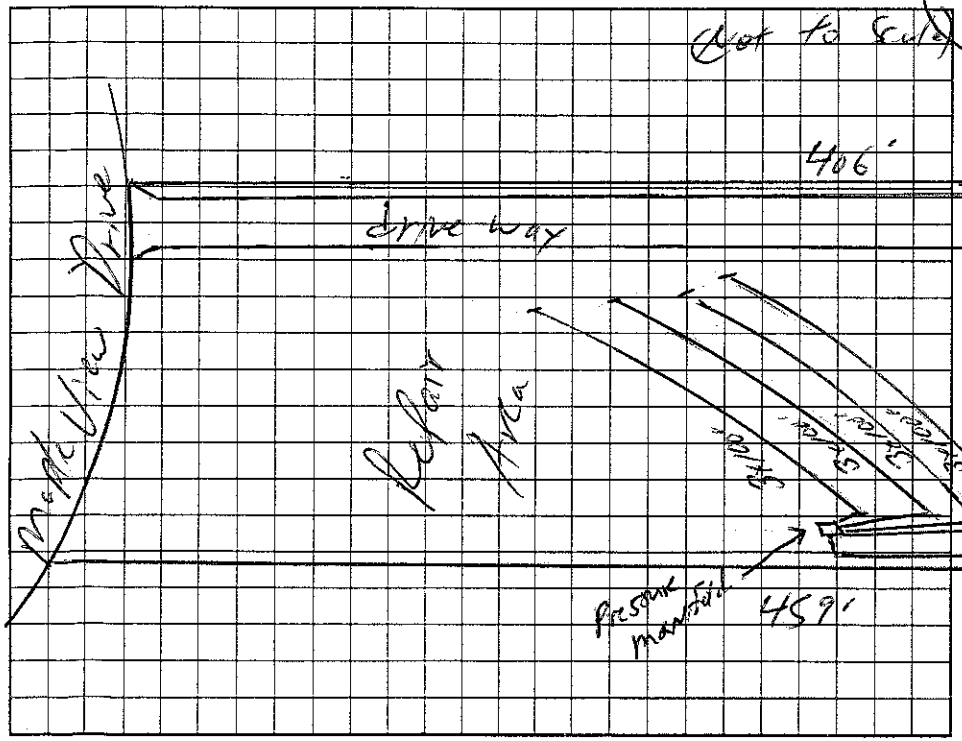

AS BUILT SKETCH

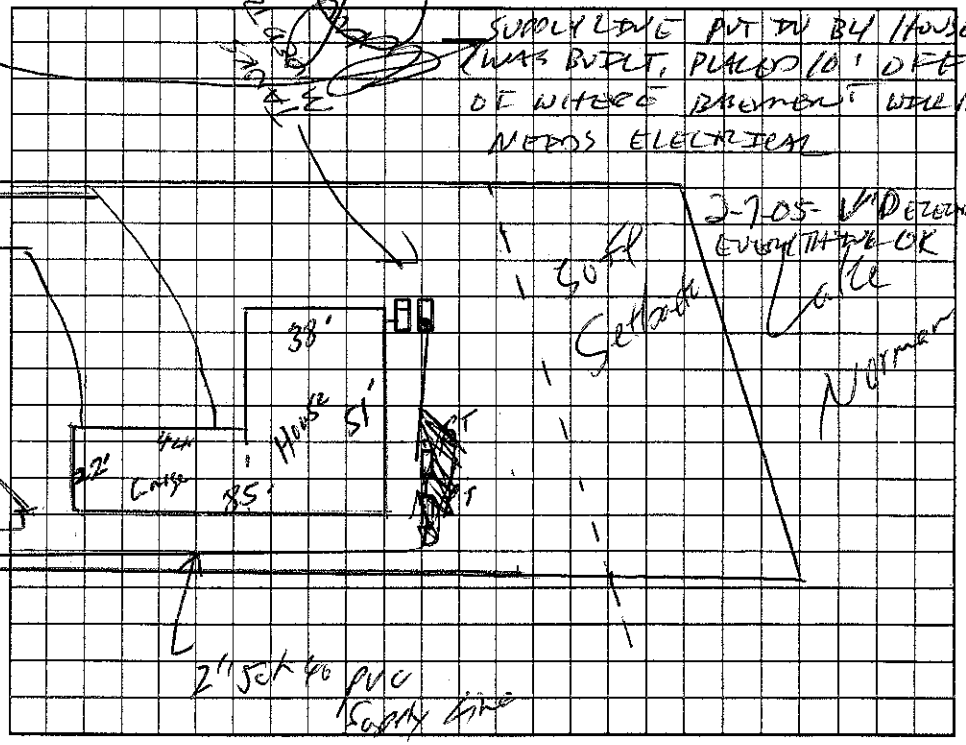

Permit can be suspended or revoked if any false information is supplied toward securing the permit/any unauthorized changes are made to the site/any unauthorized changes are made in the installation of the system. Improvement Permit with plat valid without expiration. Improvement Permit with site plan valid for sixty months. Authorization to Construct is valid for a period equal to that of Improvement Permit – not to exceed sixty months.

Signed: ____ date ____ Installed by: Curt Dunning (12-8-04)

Improvement Permit by: [signature] date 5/17/04 Operation Permit by: [signature] date 2-7-05

Authorization to Construct by: [signature] date 5/17/04 Existing System Inspection by: ____ date ____

HEALTH DEPT. COPY: WHITE OWNER COPY (FINAL): YELLOW OWNER COPY (INITIAL): PINK