IREDELL COUNTY HEALTH DEPARTMENT

Statesville Phone TR 3-7271 Mocresville Phone No. 664-5281

PERMIT TO INSTALL SEPTIC TANK

Permit No. 6[illegible] Permit Date 8-21 1973

Owner Duke Power State Park Address Troutman, NC

Installed By Robt. Hoke & R.E. Foy Address Statesville, NC

Location of Property E. Mombo Rd - LEFT AT BETHEL BAPT. CH.


BARRACKS AREA.

Tank		Capacity		Length of Lines		Fixtures TRAILER	
Block	( )	1000	(✓)	225'	(✓)	No. of Baths	( )
Precast	(✓)	1250	( )	250'	( )	Dishwasher	( )
		1500	( )	Other		Garbage Grdr.	( )
		Other				Other	

NOTIFY HEALTH DEPARTMENT AT LEAST EIGHT HOURS BEFORE TANK IS TO BE INSPECTED.

Final Inspection 8-21 1973 Approved (✓) Disapproved ( )

Remarks

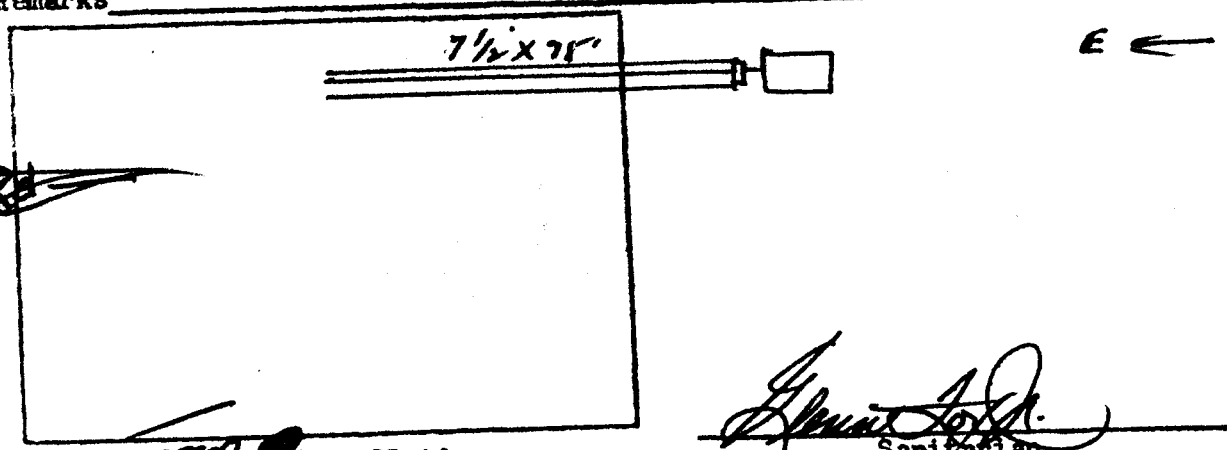

Sketch of Installation

Sanitarian