IREDELL COUNTY HEALTH DEPARTMENT

STATESVILLE 704-878-5305 MOORESVILLE 704-664-5281

IMPROVEMENT PERMIT / AUTHORIZATION TO CONSTRUCT / OPERATION PERMIT / EXISTING SYSTEM INSPECTION

PERMIT# 108878 PIN# 4720-56-9709 DATE 10/02/02

OWNER OR CONTRACTOR STATE OF NORTH CAROLINA / LAKE NORMAN STATE PARK PHONE: Business 704-528-6350 Home

ADDRESS 159 INLAND SEA LANE TROUTMAN, NC 28166

LOCATION HWY 21 S, ® PERTH RD, ® STATE PARK RD, ON LEFT INSIDE OF PARK BEFORE THE BOAT LAUNCH.

SUBDIVISION — BLOCK / SECTION — LOT — LOT AREA 1,327.15 ACRES SITE CLASS PS DESIGN FLOW 360 GPD L.T.A.R. 0.30 GPD/FT²

Septic Tank: 1,000 Gallons; STB 925 Date 9-20-04
Pump Tank: Gallons; PT Date
Pump Make: Model Serial No.
Nitrification Field: No Fields 1 Square Feet 1200 Linear Feet 400
No Lines 4 x 100' Trench Width 36" Max Trench Bottom Depth 36" Gravel Depth 12"

☒ New System ☐ Repair System Type: I (X) III, IV, V, VI
System Description: CONVENTIONAL; GRAVITY
Repair System Description: PUMP, CONV.
Maintenance Agreement Required: ☐ Yes ☒ No


☒ House/Mod. Home No. Bedrooms 3
☐ Mobile Home No. Bathrooms 2
☐ Business No. Employees
☐ Other
☐ Slab ☒ Crawl Space ☐ Basement w/plumbing ☐ Basement wo/plumbing

Water Supply: ☐ Individual ☒ Public ☐ Community


Comments:/Conditions: ① CALL AFTER CLEARING [redacted] BEFORE INSTALLATION FOR REFLAGGING IF NECESSARY ② INSTALL LINES ON CONTOUR.

Comments:/Conditions: POLYLOK FILTERS & MARKER
- INSTALLED QUICK 4 CHAMBER. APPROVAL ATTACHED
- WARRANTY ATTACHED
- TANK LOCATION CHANGED AS DRAWN - NEEDS APPROVAL
- GOT APPROVAL 11-3-04 & ATTACHED

INITIAL SITE SKETCH

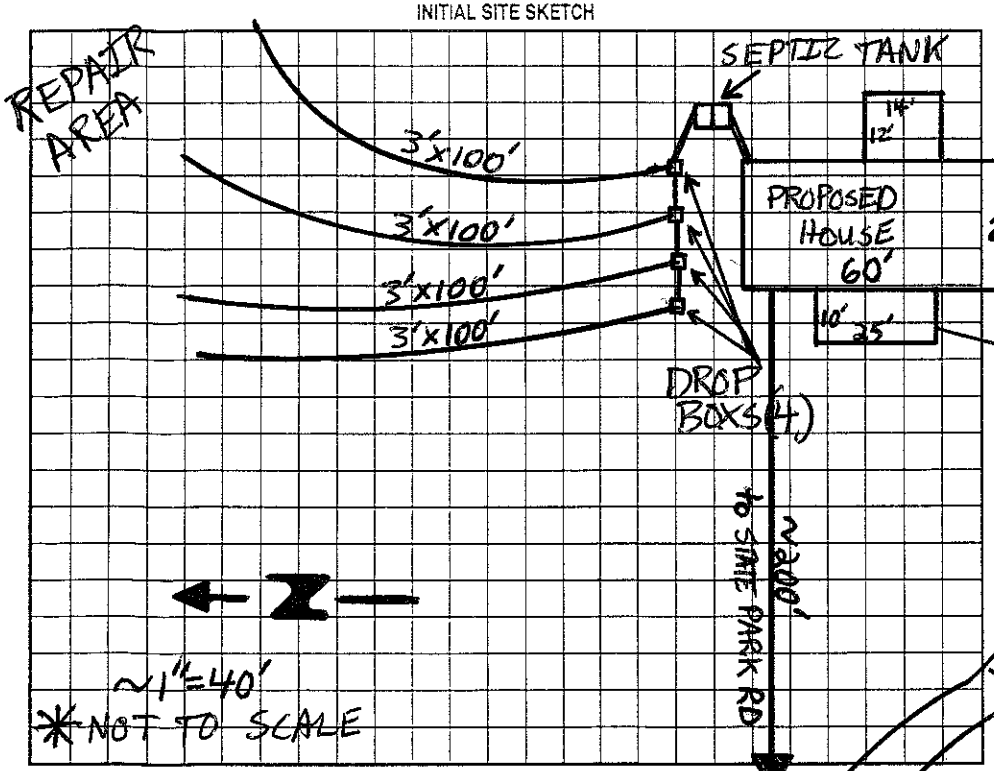

AS BUILT SKETCH 11-2-04

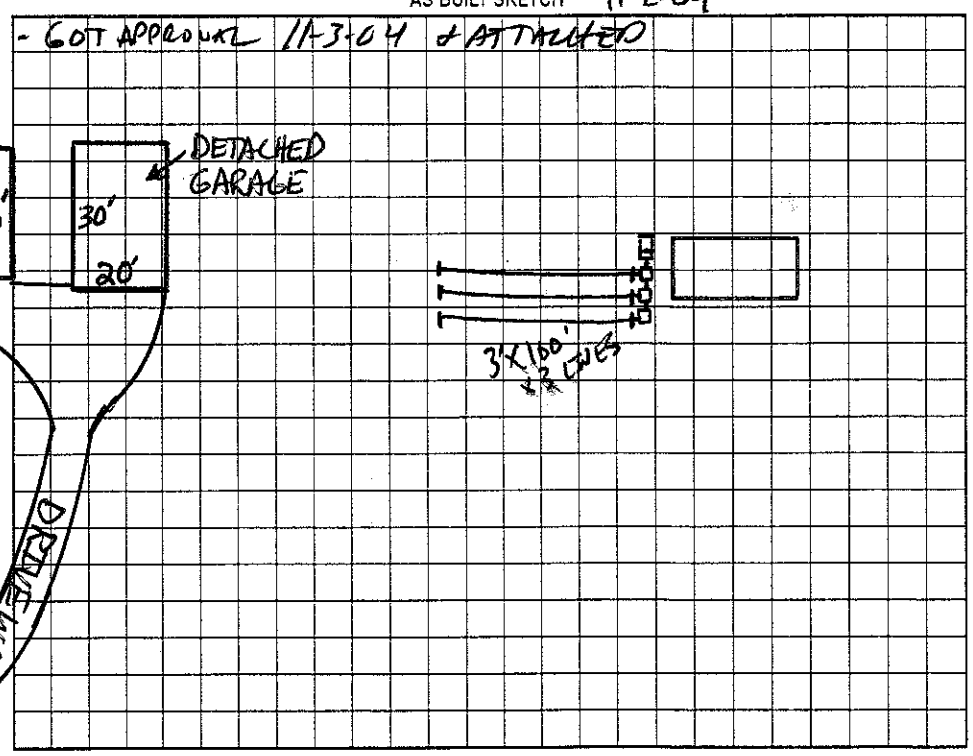

Permit can be suspended or revoked if any false information is supplied toward securing the permit/any unauthorized changes are made to the site/any unauthorized changes are made in the installation of the system. Improvement Permit with plat valid without expiration. Improvement Permit with site plan valid for sixty months. Authorization to Construct is valid for a period equal to that of Improvement Permit – not to exceed sixty months.

Signed: [signature] date 10/03/02 Installed by: CJW GRADING CONTRACTOR

Improvement Permit by: Patrick Mitchell date 10/02/02 Operation Permit by: [signature] date 11-3-04

Authorization to Construct by: Patrick Mitchell date 10/02/02 Existing System Inspection by: date

HEALTH DEPT. COPY: WHITE OWNER COPY (FINAL): YELLOW OWNER COPY (INITIAL): PINK