4720-60-0295

IREDELL COUNTY HEALTH DEPARTMENT

STATESVILLE 704-878-5305 MOORESVILLE 704-664-5281

IMPROVEMENT PERMIT / AUTHORIZATION TO CONSTRUCT / OPERATION PERMIT / EXISTING SYSTEM INSPECTION

PERMIT# 74849 PIN# 4639734550 PT 6638812 DATE 3-8-99

OWNER OR CONTRACTOR Bruce Guild PHONE Business ~~663-6905~~ Home

ADDRESS 127 milbros Ln. mooresville, N.C.

LOCATION State Pk Rd To wildlife Rd Turn into Wildlife Bay Sierra Woods 3rd lot after Deer Rd

SUBDIVISION Wildlife Bay BLOCK / SECTION I LOT 71 LOT AREA 79633 SITE CLASS PS DESIGN FLOW 360 L.T.A.R. 1.3

Septic Tank: 1000 Gallons; STB 1012 Date 6-26-99
Pump Tank: 1000 Gallons; P1 17 Date 5-26-99
Pump Make: Myers Model ME 503 Serial No 2532500
Nitrification Field: No Fields 1 Square Feet 1200 Linear Feet 400
No Lines 5 Trench Width 36" Max Trench Bottom Depth 34" Gravel Depth 12"

✓ New System Repair System Type: I II III IV V VI
System Description: Pump To conv lines
Repair System Description: 11 11 259 Rec.
Maintenance Agreement Required: Yes ✓ No

House/Mod Home No. Bedrooms 3
Mobile Home No. Bathrooms 2
Business No. Employees
Other

Slab Crawl Space ✓ Basement w/plumbing Basement wo/plumbing


Water Supply: Individual Public ✓ Community

Comments/Conditions: ✓ See Attached Sheets for Pump Tank & Pressure manifold Set up.


Comments/Conditions: Changed To 5 - 80' Lines 8-23-99 Jcm

Inspected Drain fi 8-26-99 Jcm

INITIAL SITE SKETCH

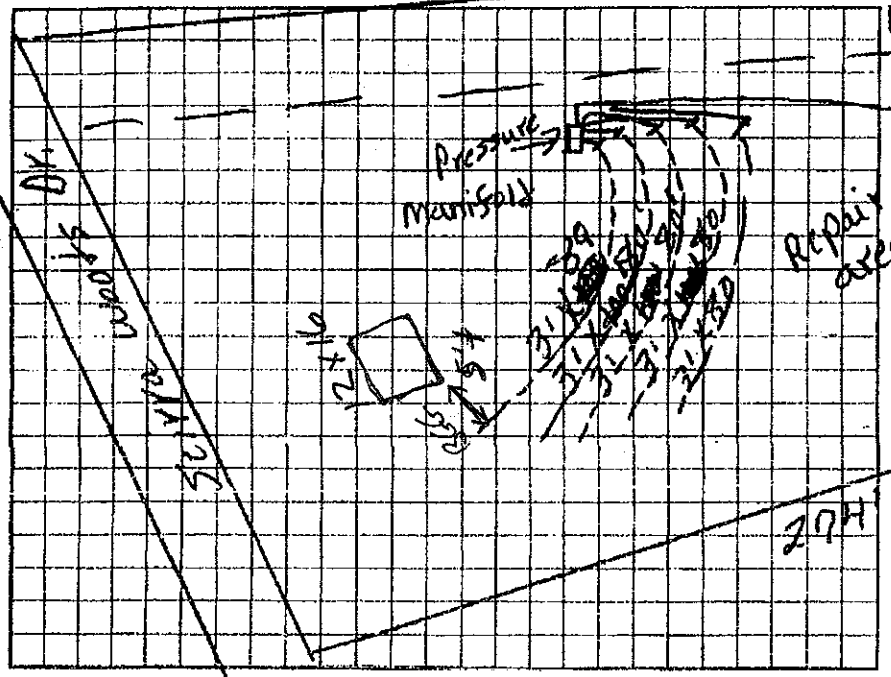

AS BUILT SKETCH

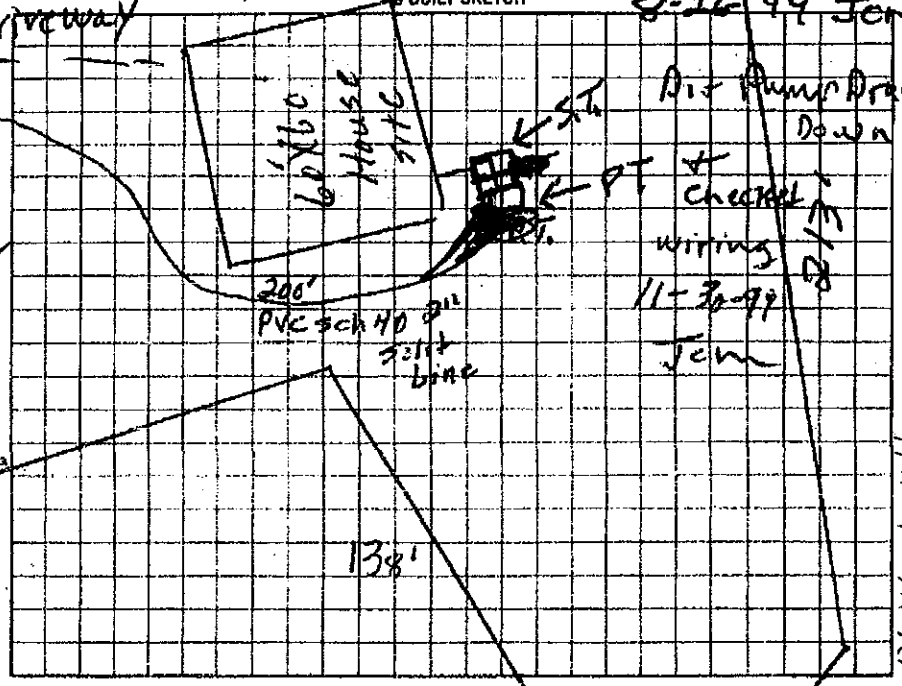

Permit can be suspended or revoked if any false information is supplied toward securing the permit/any unauthorized changes are made to the site/any unauthorized changes are made to the installation of the system. Improvement Permit with plot valid without expiration. Improvement Permit with site plan valid for sixty months. Authorization to Construct is valid for a period equal to that of Improvement Permit – not to exceed sixty months.

Signed: L. Shawn Ogden date 3-10-99
Improvement Permit by: R.C. moore date 3-8-99
Authorization to Construct by: R.C. moore date 3-8-99

Installed by: Richard Abernathy
Operation Permit by: R.C. moore date 11-30
Existing System Inspection by: date

HEALTH DEPT COPY WHITE OWNER COPY (FINAL) YELLOW OWNER COPY (INITIAL) PINK

The proposed 12'x16' outbuilding addition does not appear to impact the existing septic system.
**NOTE: Building must be 5' off septic lines R.S.
Date: 12-1-99
ICHD-Environmental Health Division