...L COUNTY HEALTH DEPARTMENT

STATESVILLE 704-878-5305 (CI) MOORESVILLE 704-664-5281

IM...OVEMENT PERMIT / AUTHORIZATION TO CONSTRUCT / OPERATION PERMIT / EXISTING SYSTEM INSPECTION

PERMIT# 121933 PIN# 4720-60-0990 DATE 7-8-04

OWNER OR CONTRACTOR EFC ASSOCIATION PHONE: Business 704 664-8047 Home 704-239-2022

ADDRESS 101 CASTLES GATE DR MOORESVILLE, NC 28117

LOCATION STATE PARK ROAD (L) WILDLIFE RD (R) SIERRA WOODS (R) MAPLE VIEW (L) LOT #83

SUBDIVISION Wildlife Bay BLOCK / SECTION 2 LOT 83 LOT AREA 42,068 +/- SITE CLASS. PS DESIGN FLOW 480 L.T.A.R. .3

Septic Tank: 1000 Gallons; STB 794 Date 12-11-04
Pump Tank: 1000 Gallons; PT 283 Date 1-9-05
Pump Make: Goulds Model WOSE Serial No.
Nitrification Field: No Fields 1 Square Feet EQ=1600 Linear Feet 270'
No Lines 6x45" Trench Width 24" Max Trench Bottom Depth 36" Gravel Depth N/A

[X] New System [ ] Repair System Type: I, II, (III) IV, V, VI
System Description: Pump 50% Reduct
Repair System Description: Low Press 50% Red
Maintenance Agreement Required: [ ] Yes [X] No


[X] House/Mod. Home No. Bedrooms 4
[ ] Mobile Home No. Bathrooms 3 1/2
[ ] Business No. Employees
[ ] Other
[ ] Slab [ ] Crawl Space [X] Basement w/plumbing [ ] Basement wo/plumbing


Water Supply: [ ] Individual [ ] Public [X] Community

Comments:/Conditions: (1) SYSTEM IS FLAGGED OUT COMPLETELY (2) INSTALL LINES ON CONTOURS (3) MAINTAIN SETBACKS (4) CALL PRIOR TO INSTALLATION FOR PUMP SIZING & SEPTIC SPECS IF NECESSARY

Comments:/Conditions: (1) MAINTAIN SETBACKS
(X) OWNER REQUESTED CHANGING SIDE SETBACK OF 35' to 25' and change the driveway side from 30' to 40'. CHANGES APPROVED CC 7-16-04
SETBACK FROM ROAD AS BUILT SKETCH WILL REMAIN 155', KEEPS APPX 5' OF P/L & 10' OFF BASEMENT, OWNER/BUILDER INITIALED CHANGES & ARE ATTACHED TO THIS PERMIT

INITIAL SITE SKETCH 1"=50'

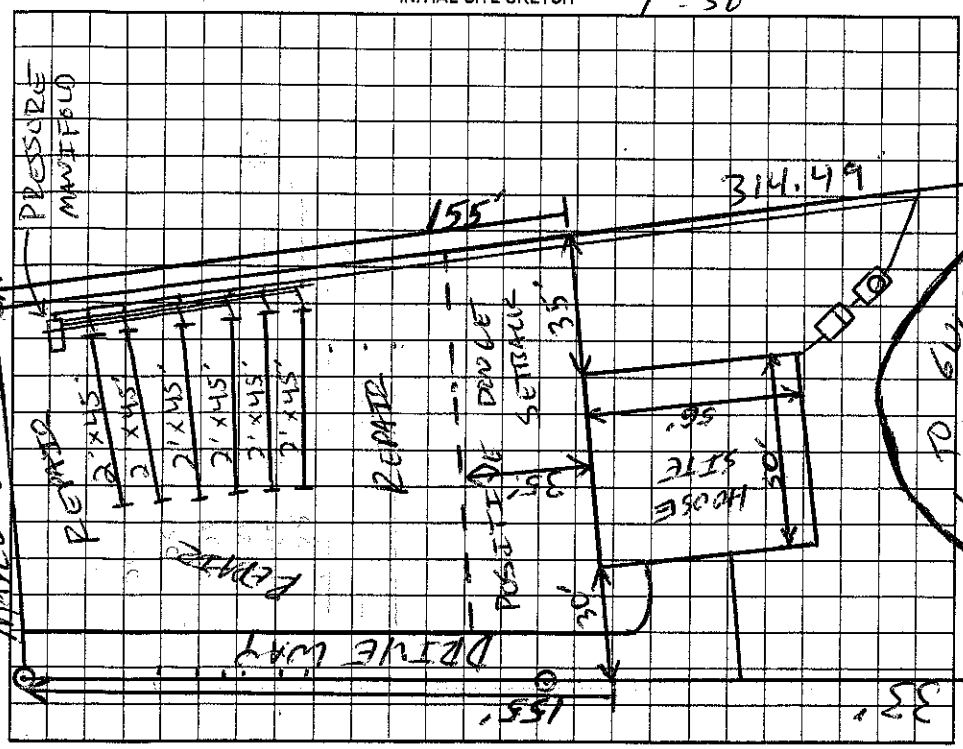

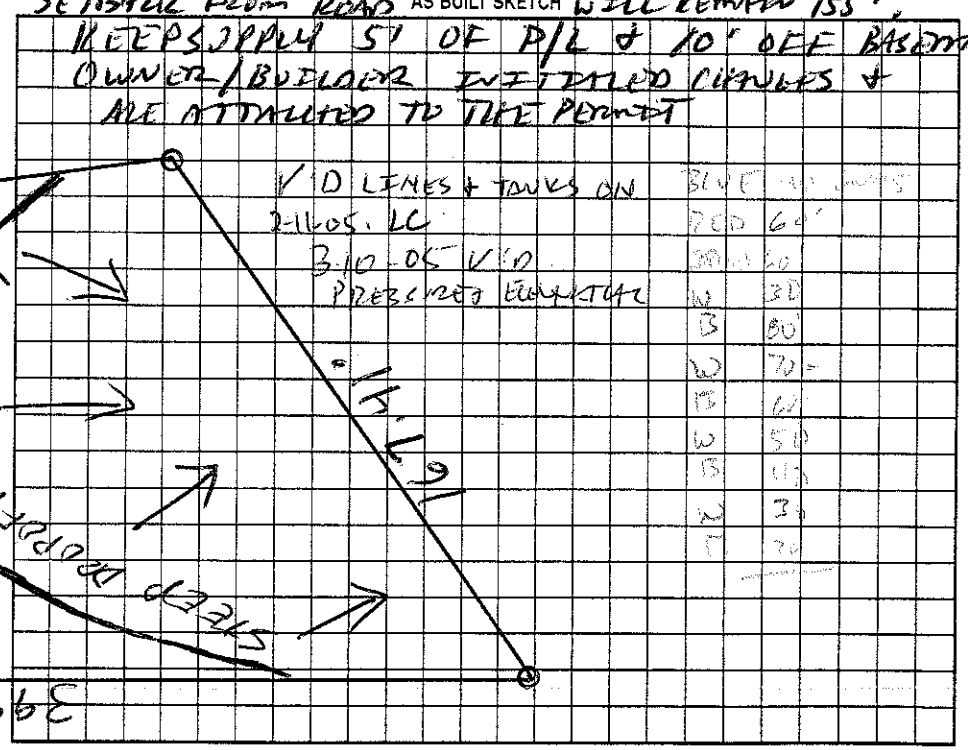

Permit can be suspended or revoked if any false information is supplied toward securing the permit/any unauthorized changes are made to the site/any unauthorized changes are made in the installation of the system. Improvement Permit with plat valid without expiration. Improvement Permit with site plan valid for sixty months. Authorization to Construct is valid for a period equal to that of Improvement Permit – not to exceed sixty months.

Signed: [signature] date 7/8/04 Installed by: RICHARD ABERNATHY

Improvement Permit by: [signature] RS date 7-8-04 Operation Permit by: [signature] RS date 3-10-05

Authorization to Construct by: [signature] RS date 7-8-04 Existing System Inspection by: date

HEALTH DEPT. COPY: WHITE OWNER COPY (FINAL): YELLOW OWNER COPY (INITIAL): PINK