IREDELL COUNTY HEALTH DEPARTMENT

This Permit Voids All Previous Permits

STATESVILLE 704-878-5305 MOORESVILLE 704-664-5281

IMPROVEMENT PERMIT / AUTHORIZATION TO CONSTRUCT / OPERATION PERMIT / EXISTING SYSTEM INSPECTION

PERMIT# 74857 PIN# 4639734550 PT WK 947-4126 DATE Oct 21, 99

OWNER OR CONTRACTOR DEBRA + MARCUS Williams PHONE: Business 987 5169 Home

ADDRESS 8738-8 Pinnacle Cr DR Huntersville NC

LOCATION Hwy 21 S (R) Perth Rd (R) State Park Rd (L) Wildlife Bay (R) Sierra Woods DR on Right

SUBDIVISION Wildlife Bay BLOCK / SECTION I LOT 77 LOT AREA 35635 SITE CLASS P5 DESIGN FLOW 480 L.T.A.R. .3

Septic Tank: 1000 Gallons; STB 823 Date 2/24/01

Pump Tank: 1000 Gallons; PT 302 Date 2/4/01

Pump Make: GOULDS Model 1PWS05111B Serial No 02732508

Nitrification Field: No Fields 1 Square Feet 1600 Linear Feet 400

No Lines 6 Trench Width 36" Max Trench Bottom Depth 36"

☑ New System ☐ Repair System Type: I, II (III) IV, V, VI

System Description: Pump - PM - 25% Reduction

Repair System Description: Pump LPP Panel BIK

Maintenance Agreement Required: ☐ Yes ☒ No

Gravel Depth N/A ☐ Slab ☐ Crawl Space ☒ Basement w/plumbing ☐ Basement wo/plumbing

☒ House/Mod. Home No. Bedrooms 4

☐ Mobile Home No. Bathrooms 4

☐ Business No. Employees

☐ Other


Water Supply: ☐ Individual ☐ Public ☒ Community

Comments/Conditions: Locate home AS To Keep 25 ft Away from Septic 66 chambers OR 40 HDJ sections


Comments/Conditions: System with basement cut. 4/5/01 - CHECKED DRAINLINES, PUMP SEPTIC TANK EVERY 3-5 YRS.

1" = 50 ft Scale

INITIAL SITE SKETCH

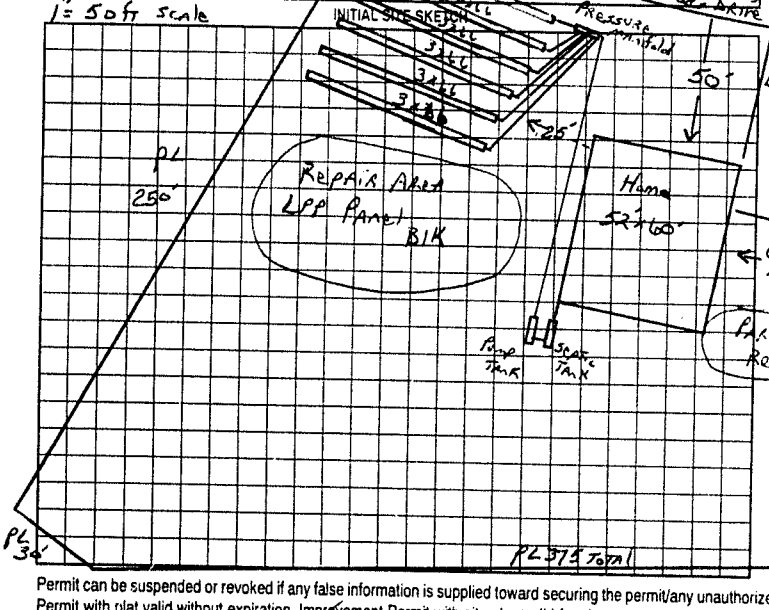

AS BUILT SKETCH

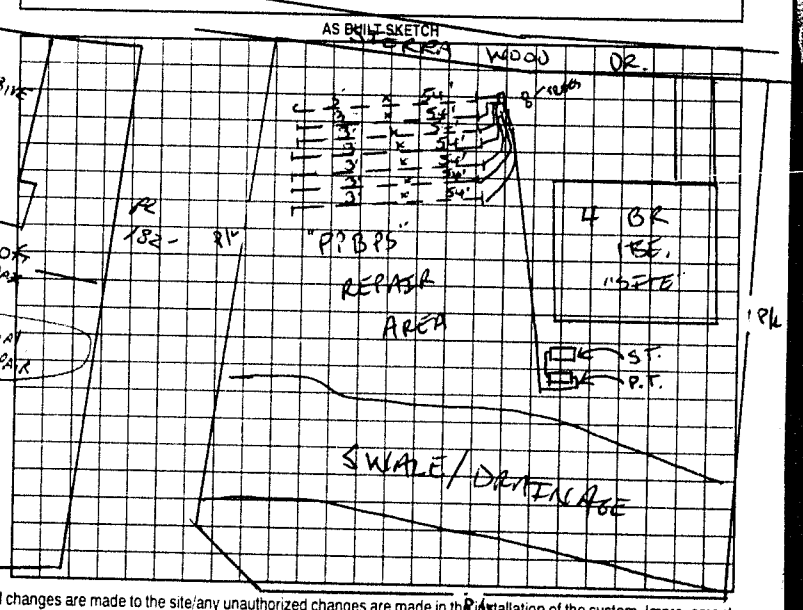

Permit can be suspended or revoked if any false information is supplied toward securing the permit/any unauthorized changes are made to the site/any unauthorized changes are made in the installation of the system. Improvement Permit with plat valid without expiration. Improvement Permit with site plan valid for sixty months. Authorization to Construct is valid for a period equal to that of Improvement Permit – not to exceed sixty months.

Signed: [signature] date 10-26-99 Installed by: WILLIE WILLIAMS

Improvement Permit by: [signature] date Oct 22 99 Operation Permit by: [signature] date 4/11/01

Authorization to Construct by: [signature] date Oct 22 99 Existing System Inspection by: date

HEALTH DEPT. COPY: WHITE OWNER COPY (FINAL): YELLOW OWNER COPY (INITIAL): PINK