THIS PERMIT VOIDS PREVIOUS ISSUED 10/23/98

IREDELL COUNTY HEALTH DEPARTMENT

STATESVILLE 704-878-5305 MOORESVILLE 704-664-5281

IMPROVEMENT PERMIT / AUTHORIZATION TO CONSTRUCT / OPERATION PERMIT / EXISTING SYSTEM INSPECTION

PERMIT# 074848 PIN# 4639734550 PT Mobile WK DATE 6-10-02

OWNER OR CONTRACTOR Nick Dimovski PHONE: Business 507-6527 892-7713 Home 548-8273

ADDRESS 2305-G Prestigious Ln Charlotte, NC 28269

LOCATION State Park Rd Rt Wildlife Bay TR Sierra Woods 2nd on left after DeerRun

SUBDIVISION Wildlife Bay BLOCK / SECTION I LOT 70 LOT AREA 47,723 SITE CLASS PS DESIGN FLOW 360gpd T.A.R. .3

Septic Tank: 1000 Gallons: STB 794 Date 07/06/02

Pump Tank: Gallons: PT Date

Pump Make: Model Serial No.

Nitrification Field: No Fields 1 Square Feet 900' Linear Feet 300

No Lines Trench Width 36" Max Trench Bottom Depth 30-36" Gravel Depth N/A

X New System ☐ Repair System Type: I. II. III. IV. V. VI

System Description: Gravity - 25% Reduction

Repair System Description Gravity - Innovative

Maintenance Agreement Required: ☐ Yes X No

X House/Mod. Home ☐ Mobile Home ☐ Business ☐ Other

No. Bedrooms 3 No. Bathrooms 2 No. Employees


X Slab ☐ Crawl Space ☐ Basement w/plumbing ☐ Basement wo/plumbing

Water Supply: ☐ Individual X Public ☐ Community


Comments/Conditions: Keep Septic System 10' from PL & at least 5' from house.

Comments/Conditions: Note: Replaces permit issued 10/1998.

INITIAL SITE SKETCH Scale: 1:50

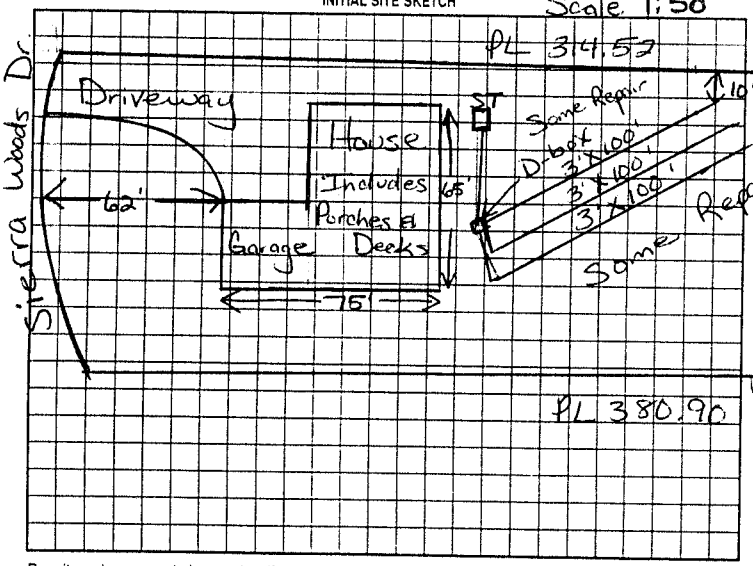

AS BUILT SKETCH

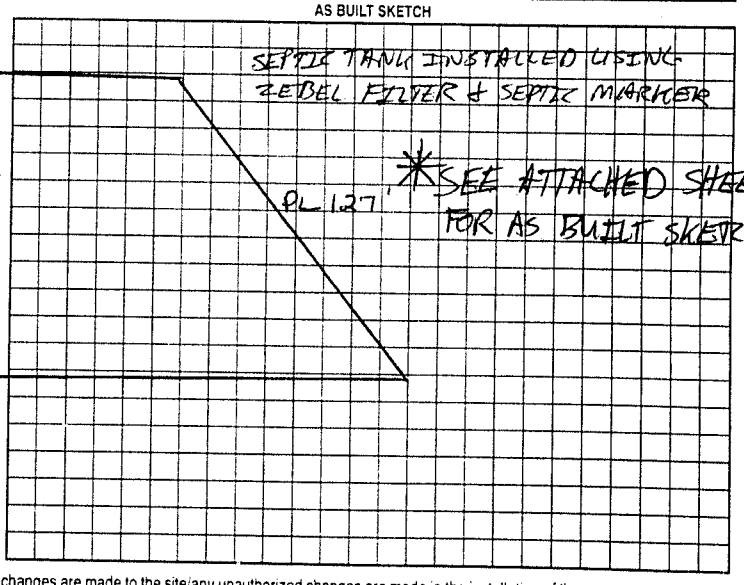

Permit can be suspended or revoked if any false information is supplied toward securing the permit/any unauthorized changes are made to the site/any unauthorized changes are made in the installation of the system. Improvement Permit with plat valid without expiration. Improvement Permit with site plan valid for sixty months. Authorization to Construct is valid for a period equal to that of Improvement Permit – not to exceed sixty months.

Signed: Nick Dimovski date 6/11/02 Installed by: RUSSEL WELL + DRILLING, HARRY TUCKER

Improvement Permit by: Maina H. Dotson RS date 6/10/02 Operation Permit by: Patrick Mitchell date 09/30/02

Authorization to Construct by: Maina H. Dotson RS date 6/10/02 Existing System Inspection by: date

HEALTH DEPT COPY: WHITE OWNER COPY (FINAL): YELLOW OWNER COPY (INITIAL): PINK