IREDELL COUNTY HEALTH DEPARTMENT

THIS PERMIT VOIDS PREVIOUS ISSUED 3/15/99

STATESVILLE 704-878-5305 (1) MOORESVILLE 704-664-5281

IMPROVEMENT PERMIT / AUTHORIZATION TO CONSTRUCT / OPERATION PERMIT / EXISTING SYSTEM INSPECTION

PERMIT# 077141 PIN# ~~4639-73-4550~~ 4720-60-2913 DATE 10/15/03

OWNER OR CONTRACTOR KEITH O'TOOLE PHONE: Business 704-309-6810 Home 704-528-7856

ADDRESS 132 SCOTCH IRISH LANE, TROUTMAN, NC 28166

LOCATION STATE PARK ROAD TO WILDLIFE ROAD, TR SIERRA WOODS DR, TR MAPLE VIEW DRIVE 5TH LOT ON LEFT

SUBDIVISION WILDLIFE BAY BLOCK / SECTION II LOT 82 LOT AREA 23,770 FT² SITE CLASS. PS DESIGN FLOW 480 L.T.A.R. 0.30 ~~0.35~~ GPD/FT²

Septic Tank: 1000 Gallons STB 3/2 Date 4-18-03

Pump Tank: ____ Gallons PT ____ Date ____

Pump Make: ____ Model ____ Serial No. ____

Nitrification Field: No Fields 1 Square Feet TO 1600 Linear Feet 390

No Lines SIX Trench Width 24" Max Trench Bottom Depth 36" ~~Gravel~~ Depth SAND 24"

☑ New System ☐ Repair System Type: I, II, (III), IV, V, VI

System Description: 50% REDUCTION, GRAVITY

Repair System Description: 50% REDUCTION, LOW PRESSURE

Maintenance Agreement Required: ☐ Yes ☑ No

☑ House/Mod. Home No. Bedrooms 4

☐ Mobile Home No. Bathrooms 2.5

☐ Business No. Employees ____

☐ Other ____


☐ Slab ☐ Crawl Space ☑ Basement w/plumbing ☐ Basement wo/plumbing

Water Supply: ☐ Individual ☑ Public ☐ Community


Comments:/Conditions: INSTALL 50% REDUCTION SYSTEM USING ~~66~~ PPBDS PANELS IN SIX EQUAL LENGTH LINES ON CONTOUR AS FLAGGED (ELEVEN PANELS PER LINE)

Comments:/Conditions: SEPTIC TANK WITH RISERS INSTALLED USING "POLYLOK" FILTER

INITIAL SITE SKETCH

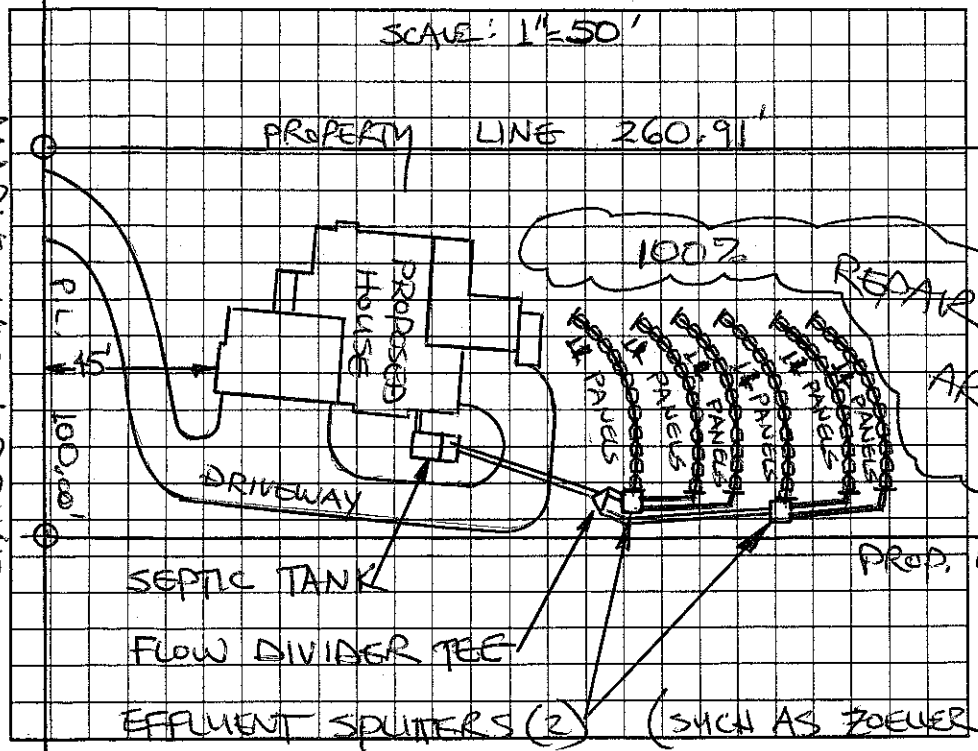

AS BUILT SKETCH

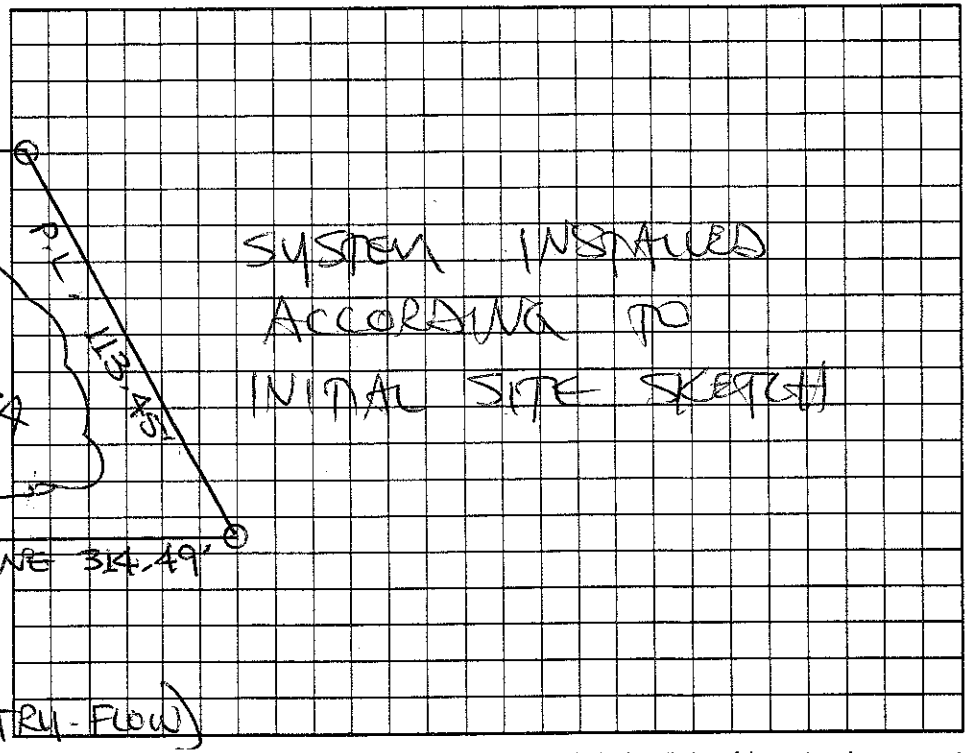

Permit can be suspended or revoked if any false information is supplied toward securing the permit/any unauthorized changes are made to the site/any unauthorized changes are made in the installation of the system. Improvement Permit with plat valid without expiration. Improvement Permit with site plan valid for sixty months. Authorization to Construct is valid for a period equal to that of Improvement Permit – not to exceed sixty months.

Signed: [signature] date 10-17-03

Improvement Permit by: STEVE HEDRICK date 10/15/03

Authorization to Construct by: STEVE HEDRICK date 10/15/03

Installed by: RICHARD ASBERNATHY

Operation Permit by: STEVE HEDRICK date 5-21-04

Existing System Inspection by: ____ date ____

HEALTH DEPT. COPY: WHITE OWNER COPY (FINAL): YELLOW OWNER COPY (INITIAL): PINK