Permit voids permit issused 9/21/98.

IREDELL COUNTY HEALTH DEPARTMENT

STATESVILLE 704-878-5305 MI MOORESVILLE 704-664-5281

IMPROVEMENT PERMIT / AUTHORIZATION TO CONSTRUCT / OPERATION PERMIT / EXISTING SYSTEM INSPECTION

PERMIT# 074846 PIN# 4639734550 PT DATE 11/19/01

OWNER OR CONTRACTOR Crescent Resources PHONE: Business _____ Home Justin Gaston (704) 892-2142

ADDRESS P.O. Box 1003 Charlotte, N.C. 28201

LOCATION State Park Rd., TL Wildlife, TR Sierra TL Deer Run 4th on left

SUBDIVISION Wildlife Bay BLOCK / SECTION 1 LOT 4 LOT AREA 36,790 sq Ft. SITE CLASS. 75 DESIGN FLOW 360 L.T.A.R. .3

Septic Tank: 1000 Gallons; STB 312 Date 5-22-02

Pump Tank: 1000 Gallons; PT 27 Date 6-13-02

Pump Make: Zoeller Model BN152-A Serial No. _____

Nitrification Field: No Fields 1 Square Feet 1200 Linear Feet 300

No Lines 5 @ 60' Trench Width 36" Max Trench Bottom Depth 36" Gravel Depth N/A

X New System ☐ Repair System Type: I, II, (III), IV, V, VI

System Description: Pump - PM - 25% Reduction

Repair System Description: Pump - 50% Reduction

Maintenance Agreement Required: ☐ Yes X No

X House/Mod. Home ☐ Mobile Home ☐ Business ☐ Other

No. Bedrooms 3 No. Bathrooms 2½ No. Employees _____


Water Supply: ☐ Individual ☐ Public X Community

☐ Slab X Crawl Space ☐ Basement w/plumbing ☐ Basement wo/plumbing


Comments/Conditions: Install lines on contour

Comments/Conditions: Checked Lines Okay - 7/26/02, Pressure Check + P.M. Okay, Poly Lok Filter Installed, 7/30/02, EZ Lay Installed. 300 Ft. (Septic Lines Raised into before they were covered.)

INITIAL SITE SKETCH

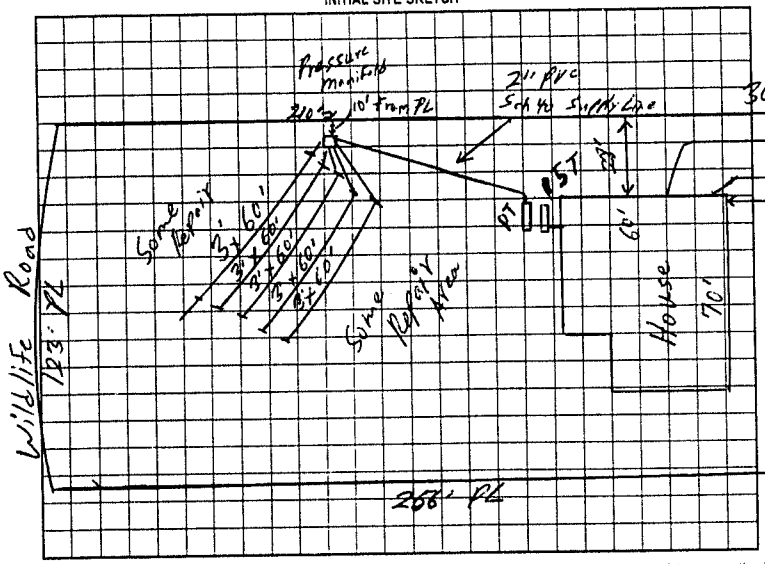

AS BUILT SKETCH

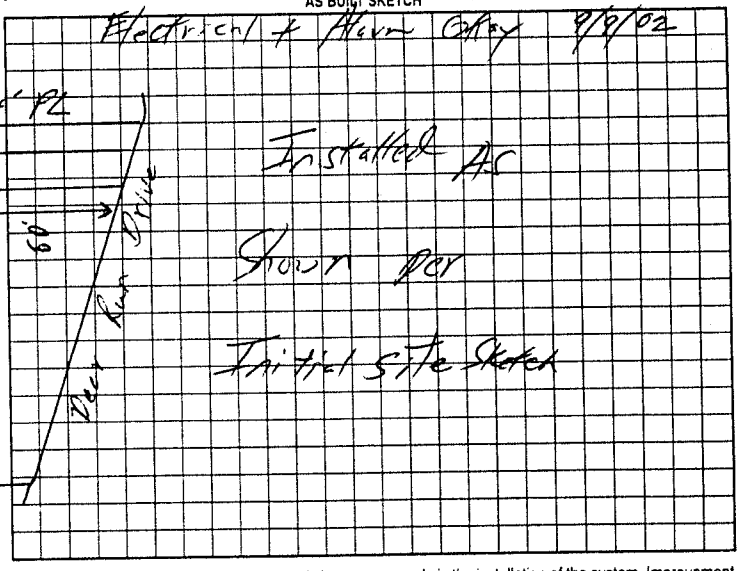

Permit can be suspended or revoked if any false information is supplied toward securing the permit/any unauthorized changes are made to the site/any unauthorized changes are made in the installation of the system. Improvement Permit with plat valid without expiration. Improvement Permit with site plan valid for sixty months. Authorization to Construct is valid for a period equal to that of Improvement Permit – not to exceed sixty months.

Signed: J. W. Hendon date 11/19/01

Improvement Permit by: William O. Johnson date 11/19/01

Authorization to Construct by: William O. Johnson date 11/19/01

Installed by: Bill Hadley To Mooresville Landscaping

Operation Permit by: William O. Johnson date 9/9/02

Existing System Inspection by: _____ date _____

HEALTH DEPT COPY: WHITE OWNER COPY (FINAL): YELLOW OWNER COPY (INITIAL): PINK