IREDELL COUNTY HEALTH DEPARTMENT

STATESVILLE 704-878-5305 MOORESVILLE 704-664-5281

IMPROVEMENT PERMIT / AUTHORIZATION TO CONSTRUCT / OPERATION PERMIT / EXISTING SYSTEM INSPECTION

CI

PERMIT# 21736 PIN# 4720-60-5185 DATE 8-3-04

OWNER OR CONTRACTOR GARLAND HOMES PHONE: Business _____ Home 704-528-2448

ADDRESS 310 WINDING SHORE RD TROUTMAN, N.C. 28166

LOCATION PERTH RD SOUTH, (R) STATE PARK (L) WILDLIFE RD (R) SIERRA WOODS (L) DEER RUN 3RD LOT ON LEFT

SUBDIVISION Wildlife BAY BLOCK / SECTION I LOT 3 LOT AREA .75AC SITE CLASS PS DESIGN FLOW 360 L.T.A.R. .3

Septic Tank: 1000 Gallons; STB 1012 Date 7-1-04

Pump Tank: 1000 Gallons; PT 17 Date 9-4-04

Pump Make: Goulds Model Webtech Serial No. mo 463752

Nitrification Field: No Fields 1 Square Feet E (L=120) Linear Feet 200'

No Lines 4 x 50' Trench Width 24" Max Trench Bottom Depth 36" Gravel Depth N/A

[X] New System [ ] Repair System Type: I, II, (III), IV, V, VI

System Description: PUMP 50% RED

Repair System Description: TO 50% RED

Maintenance Agreement Required: [ ] Yes [X] No

[X] House/Mod. Home No. Bedrooms 3

[ ] Mobile Home No. Bathrooms 2 1/2

[ ] Business No. Employees ____

[ ] Other ____

[ ] Slab [X] Crawl Space [ ] Basement w/plumbing [ ] Basement wo/plumbing

Water Supply: [ ] Individual [ ] Public [X] Community

Comments/Conditions: (1) INSTALL LINES ON CONTOURS & MAINTAIN SETBACKS (2) CALL PRIOR TO INSTALLATION FOR PUMP SIZING & SYSTEM SPECS IF NECESSARY (3) INSTALL 4 LINES


Comments/Conditions: 50' LONG WITH PRESSURE MANIFOLD. OUTFITTED FILTER & MARKER

V'D LINES & TANKS


V'D PRESSURE 1-28-05 LC V'D ELECTRICAL & PUMP 3-30-05

1"=40'

INITIAL SITE SKETCH

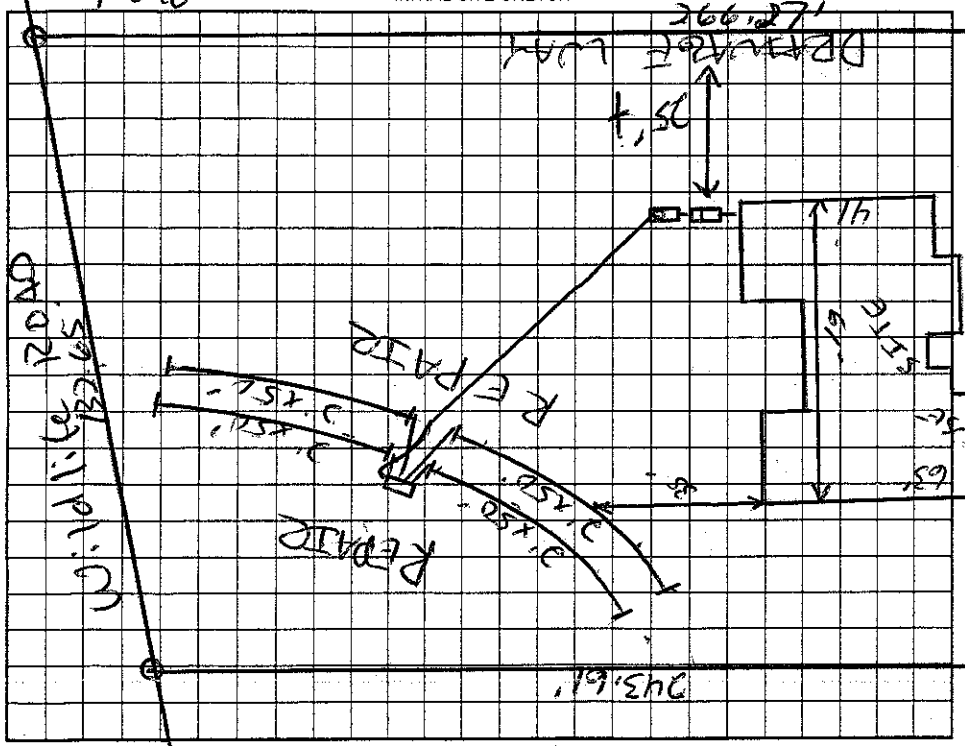

AS BUILT SKETCH 3-30-05

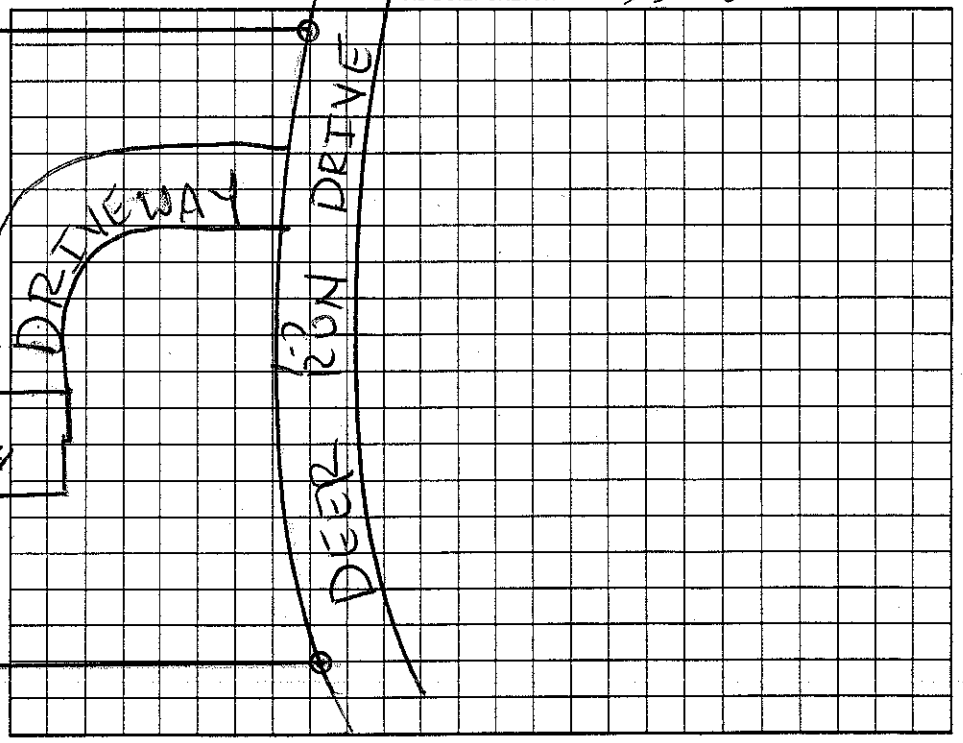

Permit can be suspended or revoked if any false information is supplied toward securing the permit/any unauthorized changes are made to the site/any unauthorized changes are made in the installation of the system. Improvement Permit with plat valid without expiration. Improvement Permit with site plan valid for sixty months. Authorization to Construct is valid for a period equal to that of Improvement Permit – not to exceed sixty months.

Signed: _____ date 8-6-04 Installed by: A-1 BACKHOE

Improvement Permit by: _____ date 8-3-04 Operation Permit by: _____ date 3-30-05

Authorization to Construct by: _____ date 8-3-04 Existing System Inspection by: _____ date _____

HEALTH DEPT. COPY: WHITE OWNER COPY (FINAL): YELLOW OWNER COPY (INITIAL): PINK