IREDELL COUNTY HEALTH DEPARTMENT

STATESVILLE 704-878-5305 MOORESVILLE 704-664-5281

IMPROVEMENT PERMIT / AUTHORIZATION TO CONSTRUCT / OPERATION PERMIT / EXISTING SYSTEM INSPECTION

PERMIT# 76983 PIN# 4639734550 PT DATE 8/25/00

OWNER OR CONTRACTOR JAMES MCGOWAN PHONE: Business 552-1431 Home

ADDRESS 5910 BELLE CHASSE ST CHARLOTTE NC 28210

LOCATION STATE PARK RD - TL WILDLIFE RD TR SIERRA WOODS DR - TL DEER RUN

SUBDIVISION WILDLIFE BAY BLOCK / SECTION I LOT 2 LOT AREA 25991 SITE CLASS PS DESIGN FLOW 360 GPD L.T.A.R. 3,241/42

Septic Tank: 1000 Gallons; STB 1012 Date 06/26/02
Pump Tank: 1000 Gallons; PT 17 Date 07/15/02
Pump Make: GOULDS Model WE05111HS Serial No. H0239534
Nitrification Field: No Fields 1 Square Feet 900 Linear Feet 300
No Lines 4@75' Trench Width 36" Max Trench Bottom Depth 36"

☑ New System ☐ Repair System Type: I. II (III) IV. V. VI
System Description: PUMP INNOVATIVE
Repair System Description: PUMP SAME
Maintenance Agreement Required: ☐ Yes ☑ No
Gravel Depth N/A ☐ Slab ☑ Crawl Space ☑ Basement w/plumbing ☐ Basement wo/plumbing


☑ House/Mod. Home No. Bedrooms 3
☐ Mobile Home No. Bathrooms 3 2
☐ Business No. Employees
☐ Other

Water Supply: ☐ Individual ☑ Public ☐ Community

Comments/Conditions:

Comments/Conditions SEPTIC TANK INSTALLED USING POLY-LOK FILTER & SEPTIC MARKER

INITIAL SITE SKETCH 1" = 50'

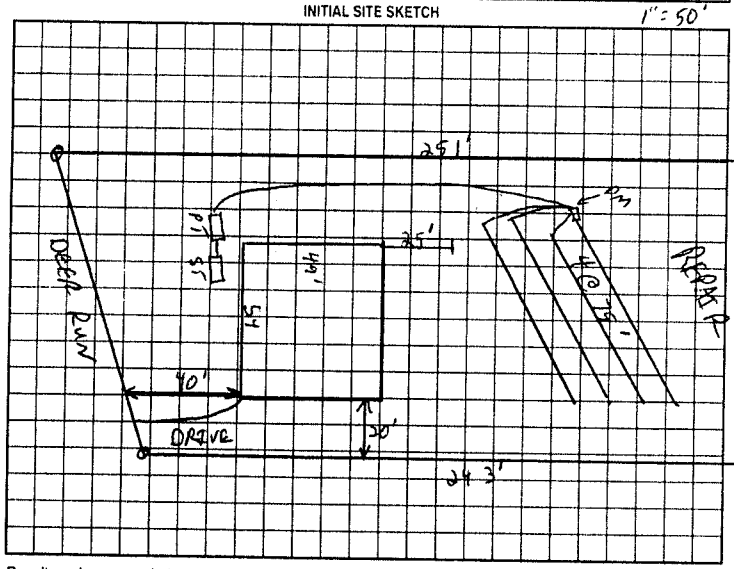

AS BUILT SKETCH

SYSTEM INSTALLED AS SHOWN IN INITIAL SITE SKETCH
- LINES CHECKED 08/23/02 PM
- PRESSURE SET 08/23/02 PM
- ELECTRICAL CHECKED + ALARM 09/23/02 PM
- ~~ELECTRICAL~~ PANEL CHECKED

Permit can be suspended or revoked if any false information is supplied toward securing the permit/any unauthorized changes are made to the site/any unauthorized changes are made in the installation of the system. Improvement Permit with plan valid without expiration. Improvement Permit with site plan valid for sixty months. Authorization to Construct is valid for a period equal to that of Improvement Permit – not to exceed sixty months.

Signed: _____ date _____

Improvement Permit by: C. Myers RS date 8/25/00

Authorization to Construct by: C. Myers RS date 8/25/00

Installed by: DAVID YOUNTZ, YOUNTZ GRADING + SEPTIC

Operation Permit by: Patrick Mitchell date 09/17/02

Existing System Inspection by: _____ date _____

HEALTH DEPT COPY. WHITE OWNER COPY (FINAL) YELLOW OWNER COPY (INITIAL) PINK