IREDELL COUNTY HEALTH DEPARTMENT

STATESVILLE 704-878-5305 MOORESVILLE 704-664-5281

IMPROVEMENT PERMIT / AUTHORIZATION TO CONSTRUCT / OPERATION PERMIT / EXISTING SYSTEM INSPECTION

PERMIT# 081802 PIN# ~~4634-73-4550 PT~~ 4620-60-7731 DATE 6-24-03

OWNER OR CONTRACTOR KOEHLER HOMES PHONE: Business 704-309-0227 Home

ADDRESS 118 HAWK RUN LANE TROUTMAN, NC 28166

LOCATION 21 SOUTH, (R) PERTH, (L) STATE PRK, (L) WILDLIFE, (R) SIENNA WOODS (R) MAPLE VIEW, 2ND LOT ON RT

SUBDIVISION Wildlife Bay BLOCK / SECTION II LOT 120 LOT AREA 36,000 S.F. SITE CLASS PS DESIGN FLOW 480 L.T.A.R. .3

Septic Tank: 1000 Gallons; STB 312 Date 10-1-03
Pump Tank: 1000 Gallons; PT 27 Date 10-16-03
Pump Make: SOULDS Model WE05511 H Serial No. 50451567
Nitrification Field: No Fields / Square Feet EQ²/600 Linear Feet 267'
No Lines 6 X 45' Trench Width 24" Max Trench Bottom Depth 36" Gravel Depth N/A

☒ New System ☐ Repair System Type: I, II, (III), IV, V, VI
System Description: PUMP PANEL / PM
Repair System Description: LP PANEL
Maintenance Agreement Required: ☐ Yes ☒ No

☒ House/Mod. Home ☐ Mobile Home ☐ Business ☐ Other
No. Bedrooms 4 No. Bathrooms 3.5 No. Employees


Water Supply: ☐ Individual ☒ Public ☒ Community

☐ Slab ☐ Crawl Space ☒ Basement w/plumbing ☐ Basement wo/plumbing


Comments:/Conditions: (1) MAKE SURE SETBACKS ARE MAINTAINED BETWEEN THE TANKS & RETAINING WALL FOUNDATION DRAINS. IF NOT THE TANKS MAY HAVE TO BE RELOCATED TO FRONT OF HOME. THIS ALSO WOULD REQUIRE RELOCATING SUPPLY LINE UNDER DRIVE

Comments:/Conditions: (2) SYSTEM & HOUSE IS COMPLETELY FLAGGED, (3) INSTALL LINES ON CONTOURS (4) MAINTAIN SETBACKS.

"NOT TO SCALE" INITIAL SITE SKETCH

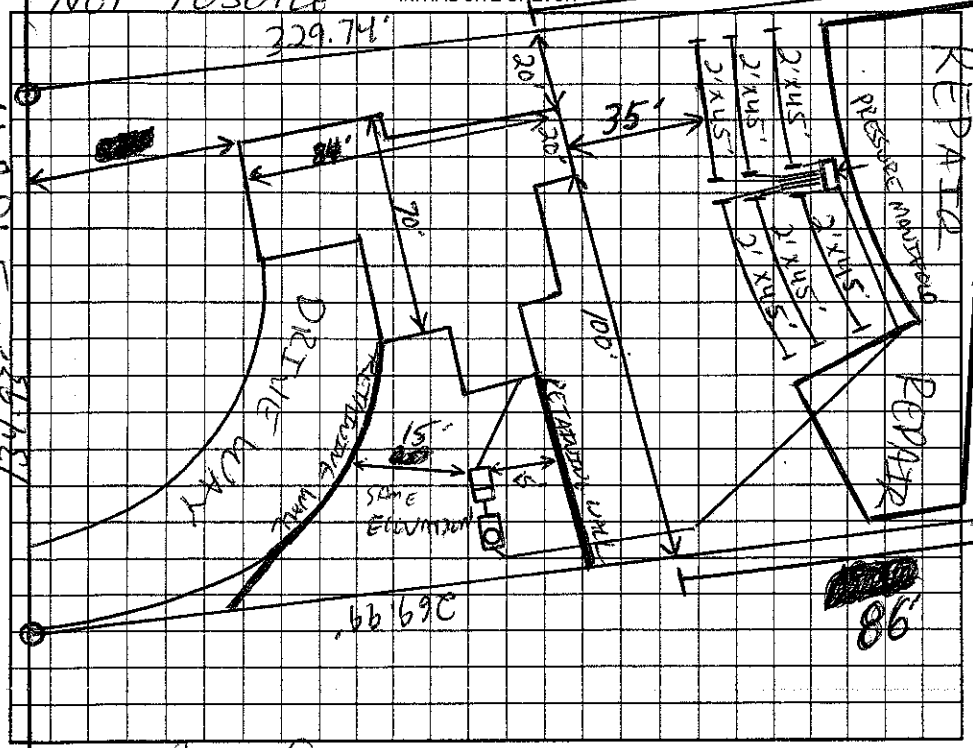

AS BUILT SKETCH

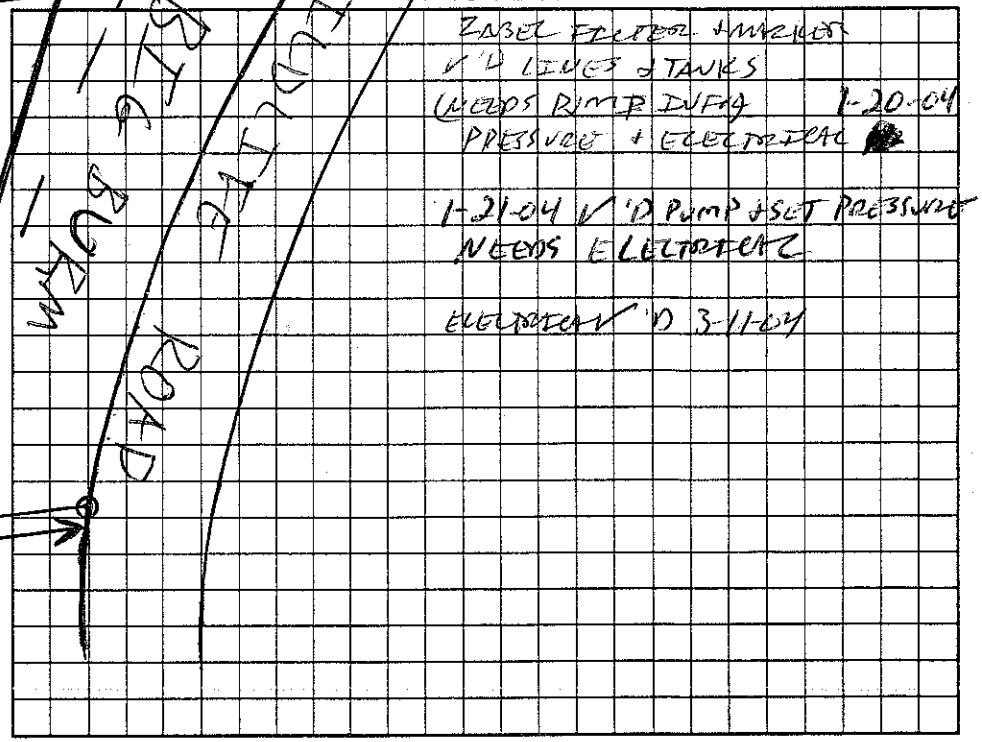

Permit can be suspended or revoked if any false information is supplied toward securing the permit/any unauthorized changes are made to the site/any unauthorized changes are made in the installation of the system. Improvement Permit with plat valid without expiration. Improvement Permit with site plan valid for sixty months. Authorization to Construct is valid for a period equal to that of Improvement Permit – not to exceed sixty months.

Signed: (AGENT (PAGES) date

Improvement Permit by: RS date 6-24-03

Authorization to Construct by: RS date 6-24-03

Installed by: CURT DUNNING

Operation Permit by: RS date 3-11-04

Existing System Inspection by: date

HEALTH DEPT. COPY: WHITE OWNER COPY (FINAL): YELLOW OWNER COPY (INITIAL): PINK