IREDELL COUNTY HEALTH DEPARTMENT

Statesville Office (704) 878-5305 Mooresville Office (704) 660-3625 PERMIT # 177235

IMPROVEMENT PERMIT / AUTHORIZATION TO CONSTRUCT / OPERATION PERMIT / EXISTING SYSTEM

PIN # 4720613410

APPLICANT: John R. McCormick Contracting APPLICANT ADDRESS: 108 Deer Cove Lane

SITE ADDRESS: 146 Maple View Dr / Troutman / NC 28166 PHONE: 704 528 7883 ALT. PHONE: 412 608 8709

SITE DIRECTIONS: Hwy 21S, (R) on Perth, (R) on State Park, (L) on Wildlife R

SUBDIVISION: Wildlife Bay SECTION: 2 LOT # 108 LOT AREA: 1.18 DESIGN FLOW: 480 L.T.A.R.: .3

Septic Tank 1000 (ex) (gal) STB 312 (ex) Date 11-8-04 (ex)
Pump Tank (gal) PT Date
Pump Make Model Serial #
Nitrification Fields 1 # Lines 5 Linear Ft: 384 (adtl)
Trench Width 36" Max. Trench Bottom Depth 32" Gravel Depth n/a

☐ New System ☐ Repair ☐ Expansion System Type: I II (III) IV V VI
System Description: Gravity 25% Reduction
Repair System Description: Pump & Panel
Maintenance Agreement Required: ☐ YES ☒ NO
☒ GRAVITY ☐ PRESSURE

☒ Residence No. Bedrooms 3
☐ Business No. Persons
☐ Other No. Employees
☐ Slab ☒ Crawl Space
☐ Basement w/plumbing ☐ Basement w/o plumbing


Water Supply
☐ Private
☒ Public
☐ Community

Comments / Conditions:

Keep 25' from end of existing line with porch foundation.

INITIAL SITE SKETCH

AS BUILT SKETCH

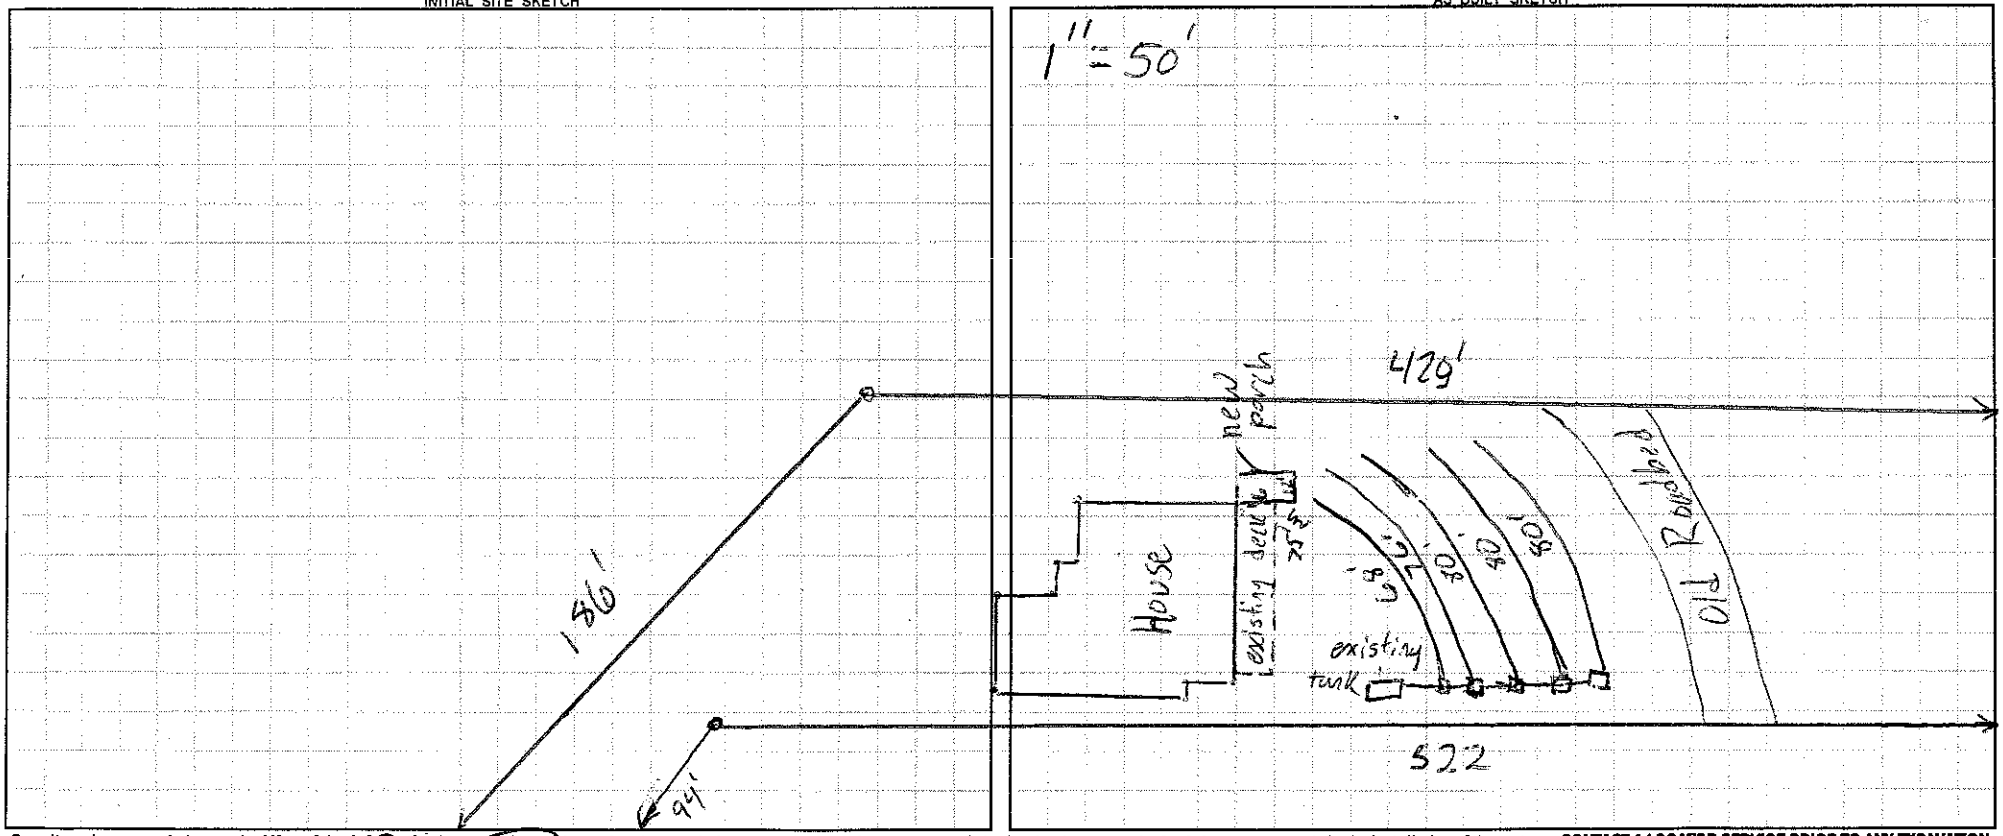

Permit can be suspended or revoked if any false information is supplied toward securing the permit / any unauthorized changes are made to the site / any unauthorized changes are made in the installation of the system. **CONTACT A LOCATOR SERVICE PRIOR TO ANY EXCAVATION**

☐ **IMPROVEMENT PERMIT** *with plan valid without expiration.* ☐ **IMPROVEMENT PERMIT** *with site plan valid for 60 mos.* ☐ **AUTHORIZATION TO CONSTRUCT** *valid for period equal to IMPROVEMENT PERMIT--not to exceed 60 mo.*

Owner / Applicant Signature: Date: Installed by:

IMPROVEMENT PERMIT by: Date: OPERATION PERMIT by: Date:

AUTHORIZATION TO CONSTRUCT by: Date: Existing System Inspected by: Date: 3-5-13

Health Dept. Copy - WHITE Applicant (Final Approval) - YELLOW Applicant (Conditional Approval) - PINK