0677 4720-61-4316 THIS PERMIT VOIDS PREVIOUS ISSUED 12-21-2000

IREDELL COUNTY HEALTH DEPARTMENT

STATESVILLE 704-878-5305 MOORESVILLE 704-664-5281

IMPROVEMENT PERMIT / AUTHORIZATION TO CONSTRUCT / OPERATION PERMIT / EXISTING SYSTEM INSPECTION

PERMIT# 077079 PIN# ~~4639 73 4530~~ 4720-61-4316 HORATIO BAY OBSERVE 704-528-2801 DATE 1-4-2002

OWNER OR CONTRACTOR CRESCENT RESOURCES PHONE: Business (704) 663-6905 Home (704) 799-3041

ADDRESS P.O. BOX 1003, CHARLOTTE NC 28201

LOCATION STATE PARK RD, TL WILDLIFE, TR SIERRA WOODS, TR MAPLE VIEW, LOT #109 ON RIGHT

SUBDIVISION WILDLIFE BAY BLOCK / SECTION II LOT 109 LOT AREA 56,958 FT² SITE CLASS PS DESIGN FLOW 480 L.T.A.R. 0.30 GPD/FT²

Septic Tank: 1000 Gallons; STB 70C Date 2-13-02
Pump Tank: 1000 Gallons; PT ~~77~~ Date 10-16-01
Pump Make: Little Giant Model 20E-CIM Serial No. 520250
Nitrification Field: No Fields 1 Square Feet EQ. TO 1600 Linear Feet 400
No Lines FIVE Trench Width 36" Max Trench Bottom Depth 36" Gravel Depth N/A


☑ New System ☐ Repair System Type: I, II, (III) IV, V, VI
System Description: 25% REDUCTION PUMP
Repair System Description: 50% REDUCTION, PUMP
Maintenance Agreement Required: ☐ Yes ☑ No

☑ House/Mod. Home No. Bedrooms 4
☐ Mobile Home No. Bathrooms 4
☐ Business No. Employees
☐ Other
☐ Slab ☐ Crawl Space ☑ Basement w/plumbing ☐ Basement wo/plumbing

Water Supply: ☐ Individual ☑ Public ☐ Community


Comments/Conditions: ① INSTALL 25% REDUCTION SYSTEM IN FIVE EQUAL LENGTH LINES ON CONTOUR AS SHOWN (AS FLAGGED) ② SEE ATTACHED SHEETS FOR PUMP AND PRESSURE MANIFOLD REQUIREMENTS

INITIAL SITE SKETCH

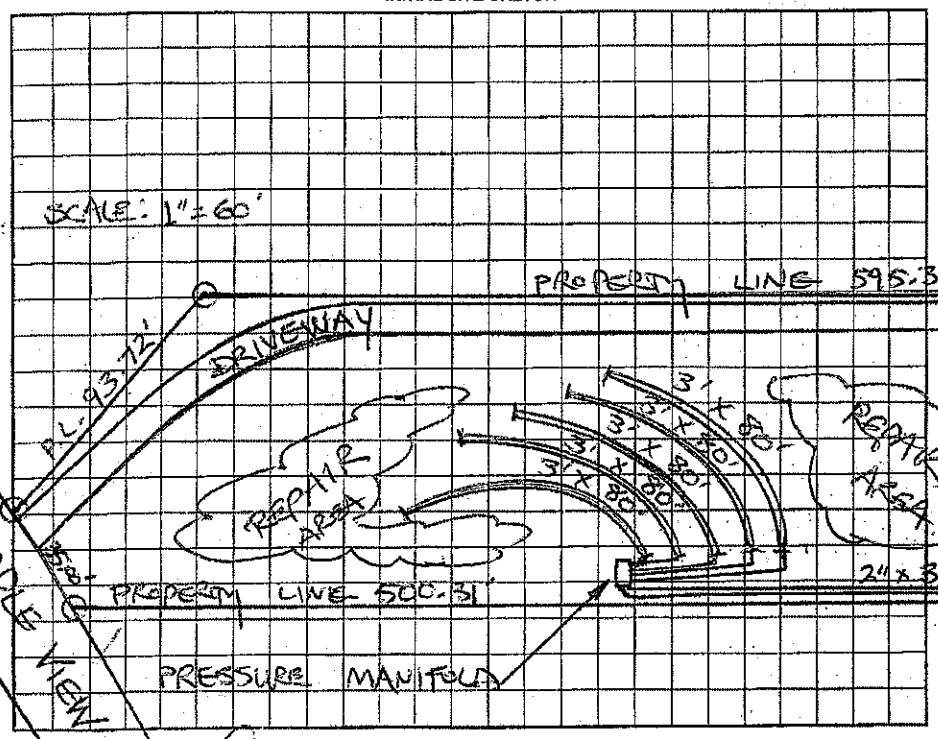

Comments/Conditions: POLYLOK FILTER SMALLER TANKS V'D ON 07-08-02 V'D LINES ON 7-9-02, LL/PM - NEEDS ELECTRICAL & PRESSURE. / V'D PRESSURE NEEDS ELECTRICAL & FLOAT TREE. LL 07-05-02

AS BUILT SKETCH

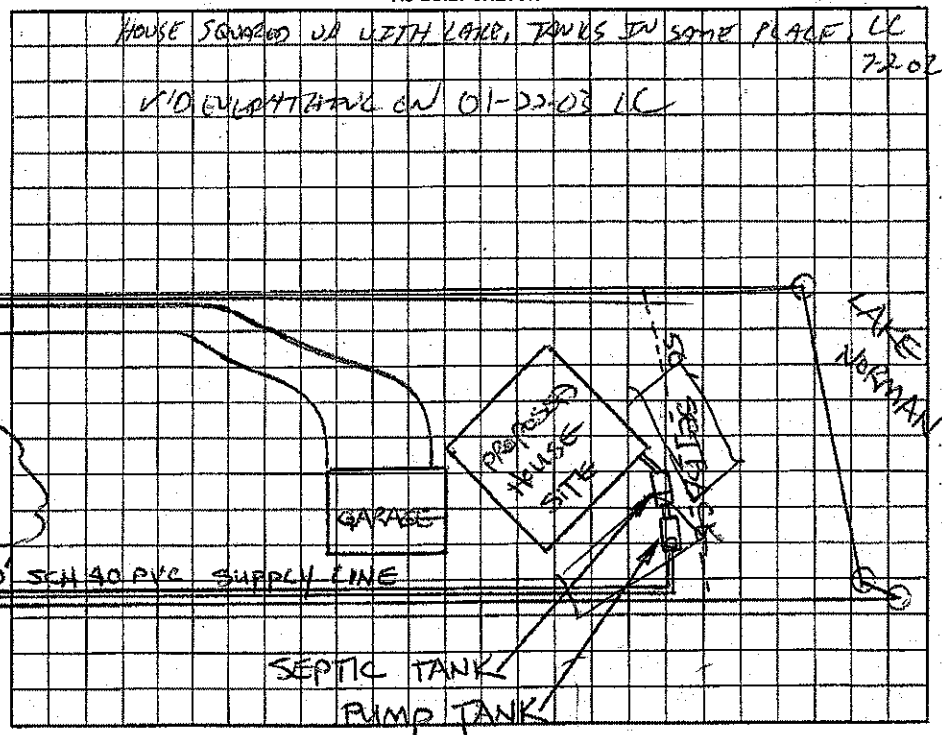

Permit can be suspended or revoked if any false information is supplied toward securing the permit/any unauthorized changes are made to the site/any unauthorized changes are made in the installation of the system. Improvement Permit with plat valid without expiration. Improvement Permit with site plan valid for sixty months. Authorization to Construct is valid for a period equal to that of Improvement Permit – not to exceed sixty months.

Signed: _____ date 1/14/02 Installed by: A-1 BACKHOE

Improvement Permit by: STEVE HEARICK date 1-4-2002 Operation Permit by: _____ date 01-22-03

Authorization to Construct by: STEVE HEARICK date 1-4-2002 Existing System Inspection by: _____ date _____

HEALTH DEPT. COPY: WHITE OWNER COPY (FINAL): YELLOW OWNER COPY (INITIAL): PINK