IREDELL COUNTY HEALTH DEPARTMENT

Statesville Office (704) 878-5305 Mooresville Office (704) 660-3625 PERMIT # 209551

IMPROVEMENT PERMIT / AUTHORIZATION TO CONSTRUCT / OPERATION PERMIT / EXISTING SYSTEM

PIN # 4720614316

APPLICANT: Superior Pools APPLICANT ADDRESS: 20315 Knox Rd Cornelius NC 28031

SITE ADDRESS: 144 Maple View Dr Troutman NC 28166 PHONE: 704-896-7665 ALT. PHONE: 704-980-9810


SITE DIRECTIONS: State Park Rd T/L Wildlife T/R Sierra Woods T/R Maple View Lot on right

SUBDIVISION: Wildlife Bay SECTION: P2 LOT # 109 LOT AREA: 1.31ac DESIGN FLOW: Ex L.T.A.R.: Ex


Septic Tank	Ex	(gal)	STB		Date	☐ New System	☐ Repair	☐ Expansion	System Type: I II III IV V VI	☐ Residence	No. Bedrooms	Ex	Water Supply		
Pump Tank		(gal)	PT		Date	System Description:	Existing			☒ Business	No. Persons	Ex	☐ Private		
Pump Make		Model			Serial #	Repair System Description:				☐ Other	No. Employees		☒ Public		
# Nitrification Fields	Ex	# Lines	Ex	Linear Ft:	Ex	Maintenance Agreement Required:	☐ YES	☒ NO		☐ Slab	☐ Crawl Space		☐ Community		
Trench Width	Ex	Max. Trench Bottom Depth	Ex	Gravel Depth	Ex		☒ GRAVITY	☐ PRESSURE		☒ Basement w/plumbing			☐ Basement w/o plumbing		

Comments / Conditions: All pools must be 5.15' from any part of STS.

INITIAL SITE SKETCH

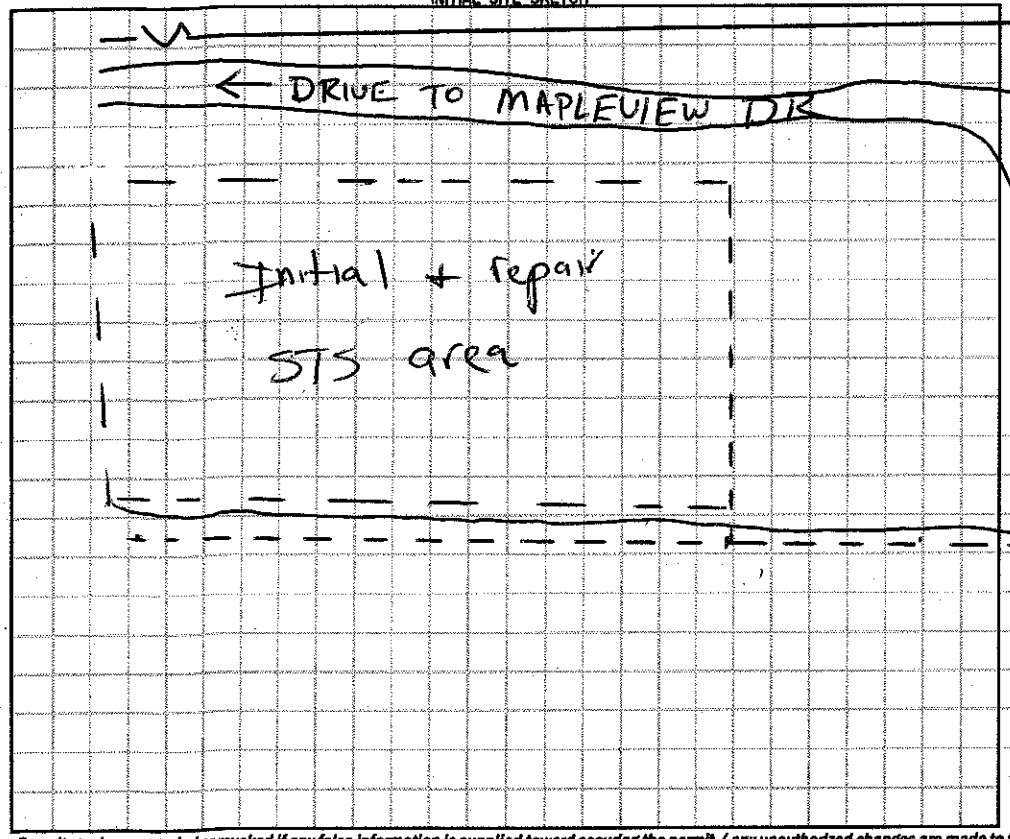

AS BUILT SKETCH

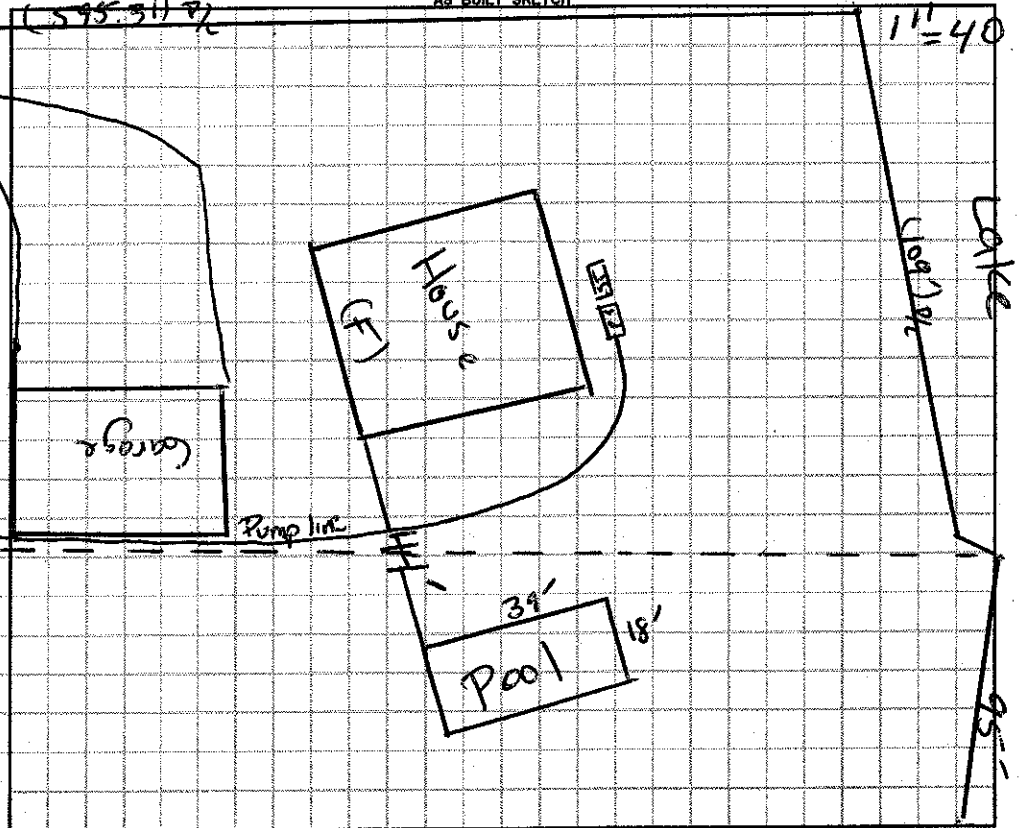

Permit can be suspended or revoked if any false information is supplied toward securing the permit / any unauthorized changes are made to the site / any unauthorized changes are made in the installation of the system. **CONTACT A LOCATOR SERVICE PRIOR TO ANY EXCAVATION**

☐ **IMPROVEMENT PERMIT** *with plat valid without expiration.* ☐ **IMPROVEMENT PERMIT** *with site plan valid for 60 mos.* ☐ **AUTHORIZATION TO CONSTRUCT** *valid for period equal to IMPROVEMENT PERMIT--not to exceed 60 mo.*

Owner / Applicant Signature: _____ Date: 8-24-15 Installed by: _____

IMPROVEMENT PERMIT by: _____ Date: _____ OPERATION PERMIT by: _____ Date: _____

AUTHORIZATION TO CONSTRUCT by: _____ Date: _____ Existing System Inspected by: _____ Date: 08/19/15

Health Dept. Copy - WHITE Applicant (Final Approval) - YELLOW Applicant (Conditional Approval) - PINK