IREDELL COUNTY HEALTH DEPARTMENT

STATESVILLE 704-878-5305 50.00 Paid MOORESVILLE 704-664-5281

IMPROVEMENT PERMIT / AUTHORIZATION TO CONSTRUCT / OPERATION PERMIT / EXISTING SYSTEM INSPECTION

PERMIT# 077085 PIN# 4639734550 Oscar Koehler DATE 3-21-2002

OWNER OR CONTRACTOR Mike Riddell (formerly CRI) PHONE: Business 309-0227 Home 662-9490

ADDRESS 118 Hawk Run Ln Troutman NC 28166

LOCATION State Park Rd TL Wildlife TR Sierra Woods TR Maple View

SUBDIVISION Wildlife Bay BLOCK / SECTION II LOT 112 LOT AREA 49,210 ft² SITE CLASS PS DESIGN FLOW 480gpd L.T.A.R. .3

Septic Tank: 1000 Gallons, STB 794 Date 09/01/02
Pump Tank: ______ Gallons, PT ______ Date ______
Pump Make: ______ Model ______ Serial No. ______
Nitrification Field: No Fields 1 Square Feet 1200' Linear Feet 400'
No Lines 3@133' Trench Width 36" Max Trench Bottom Depth 36"+ Gravel Depth N/A

X New System ☐ Repair System Type I II III IV V VI
System Description: Gravity *25% Reduction
Repair System Description: Gravity - Innovative
Maintenance Agreement Required: ☐ Yes X No


X House/Mod. Home ☐ Mobile Home ☐ Business ☐ Other ______
No. Bedrooms 4 No. Bathrooms 3.5 No. Employees ______
☐ Slab ☐ Crawl Space X Basement w/plumbing ☐ Basement wo/plumbing

Water Supply: ☐ Individual X Public X Community


Comments:/Conditions: Keep Septic System at least 10' from PL. Okay to use distribution box or "drop boxes".

Comments:/Conditions: * 25% Reduction in Drainfield area. SEPTIC TANK INSTALLED USING ZEBEL FILTER + SEPTIC MARKER.

INITIAL SITE SKETCH Scale 1:50

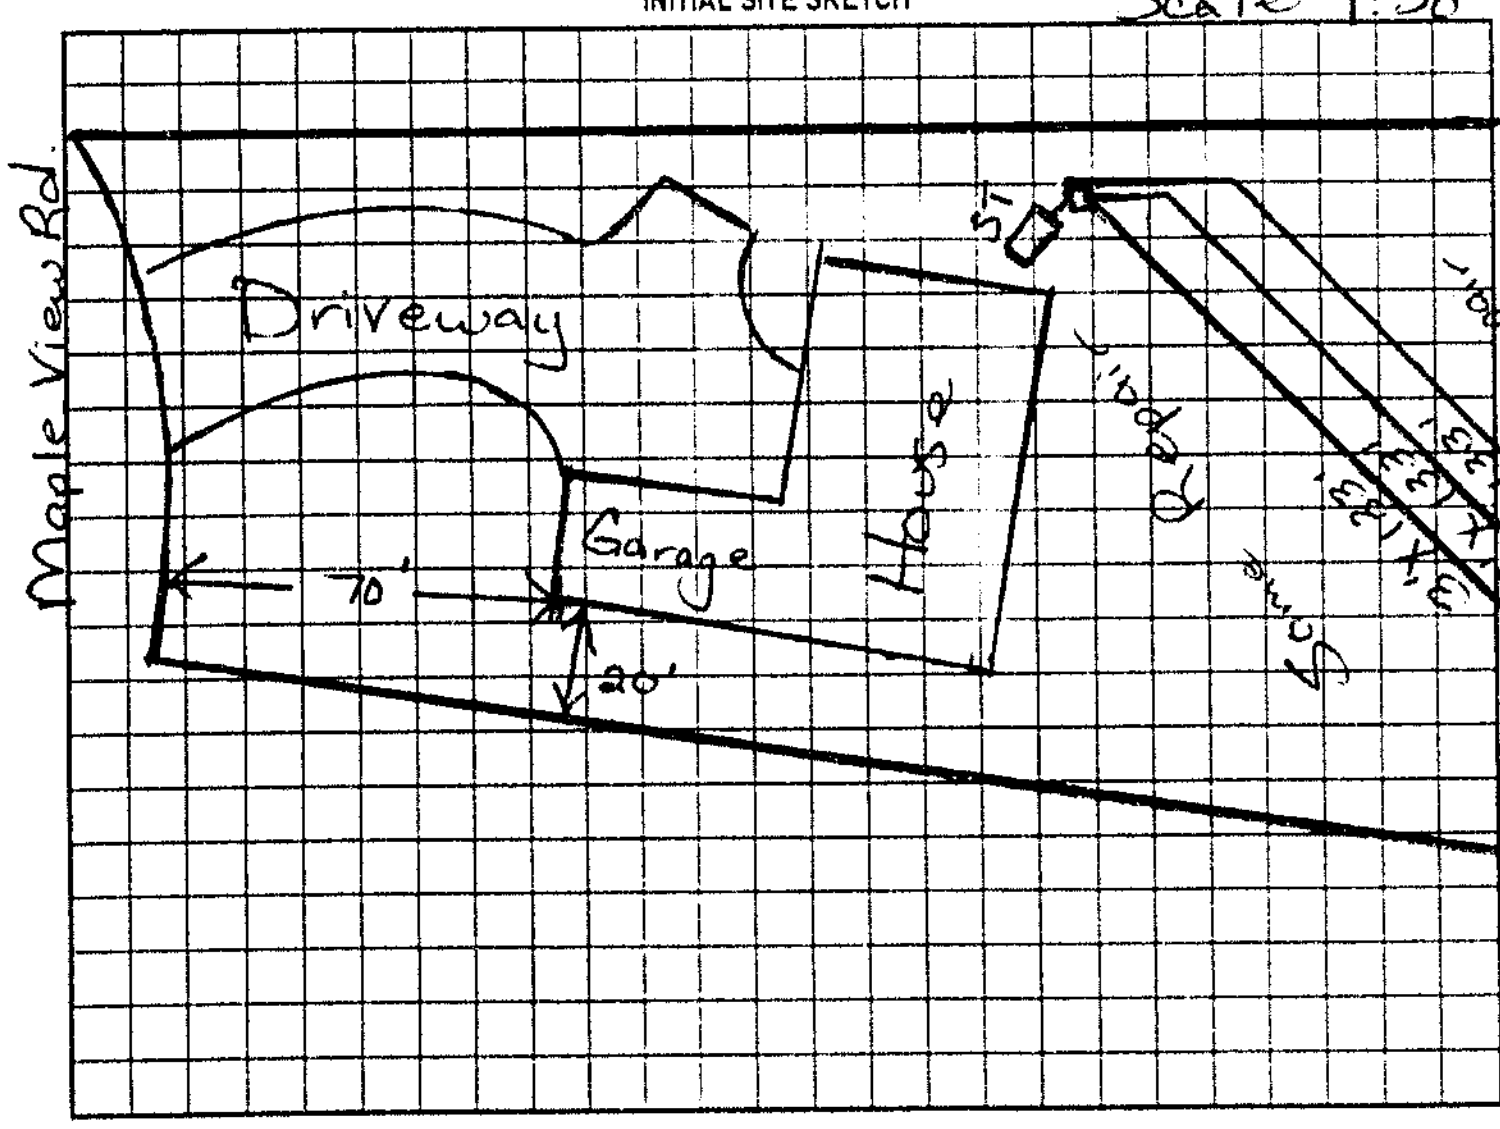

AS BUILT SKETCH

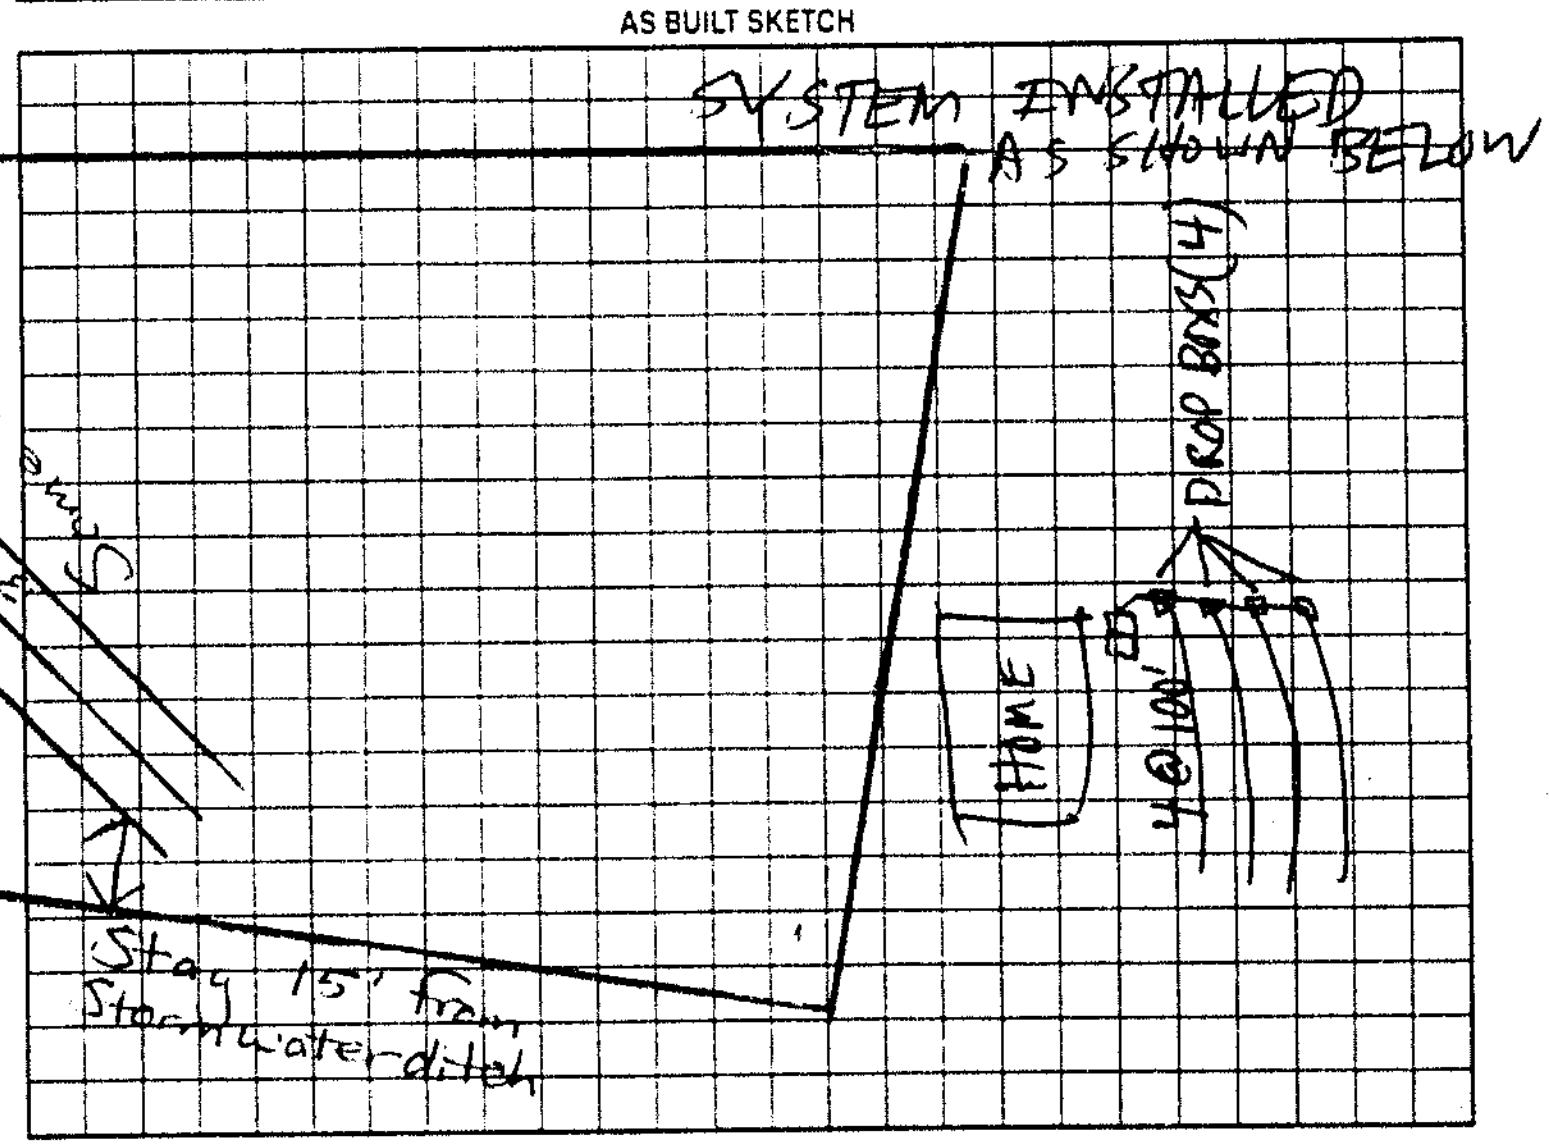

Permit can be suspended or revoked if any false information is supplied toward securing the permit/any unauthorized changes are made to the site any unauthorized changes are made in the installation of the system. Improvement Permit with plat valid without expiration. Improvement Permit with site plan valid for sixty months. Authorization to Construct is valid for a period equal to that of Improvement Permit - not to exceed sixty months

Signed: [signature] date 3/22/02 Installed by: KURT DUNNING CONSTRUCTION

Improvement Permit by: Maria H Dotson RS date 3/21/2002 Operation Permit by: Patrick Mitchell date 10/10/02

Authorization to Construct by: Maria H Dotson RS date 3/21/2002 Existing System Inspection by: ______ date ______

HEALTH DEPT COPY WHITE OWNER COPY (FINAL) YELLOW OWNER COPY (INITIAL) PINK